


T.1S. R.45E. W.M.

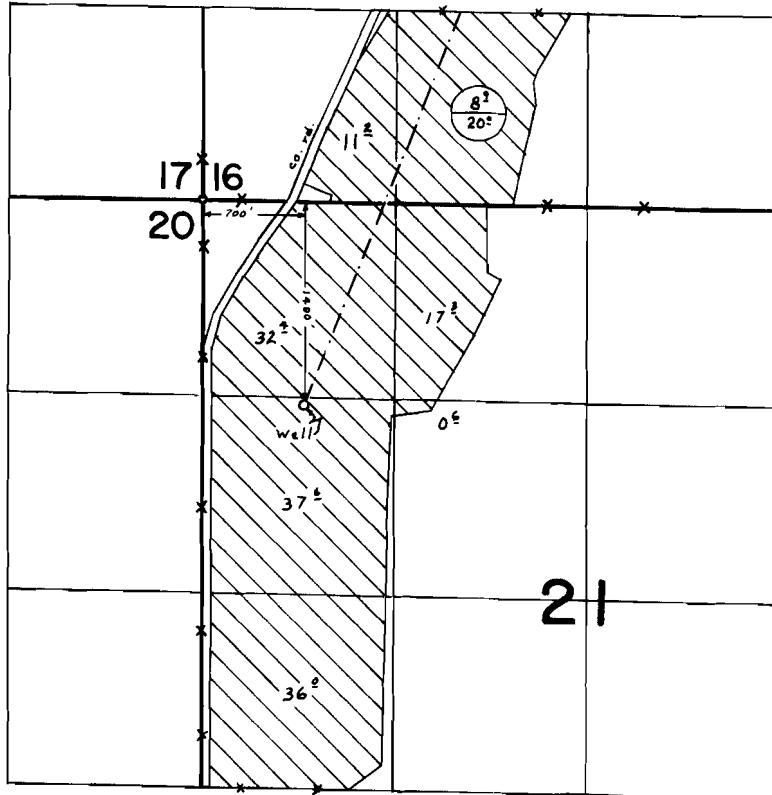

**FINAL PROOF SURVEY**  
UNDER

Application No. G-4239 Permit No. G-4001  
IN NAME OF

*Gregory J. Wieck*

Surveyed AUG. 2, 1973, by K. MUCKEN