





T. 31 S., R. 15 W., W. M.

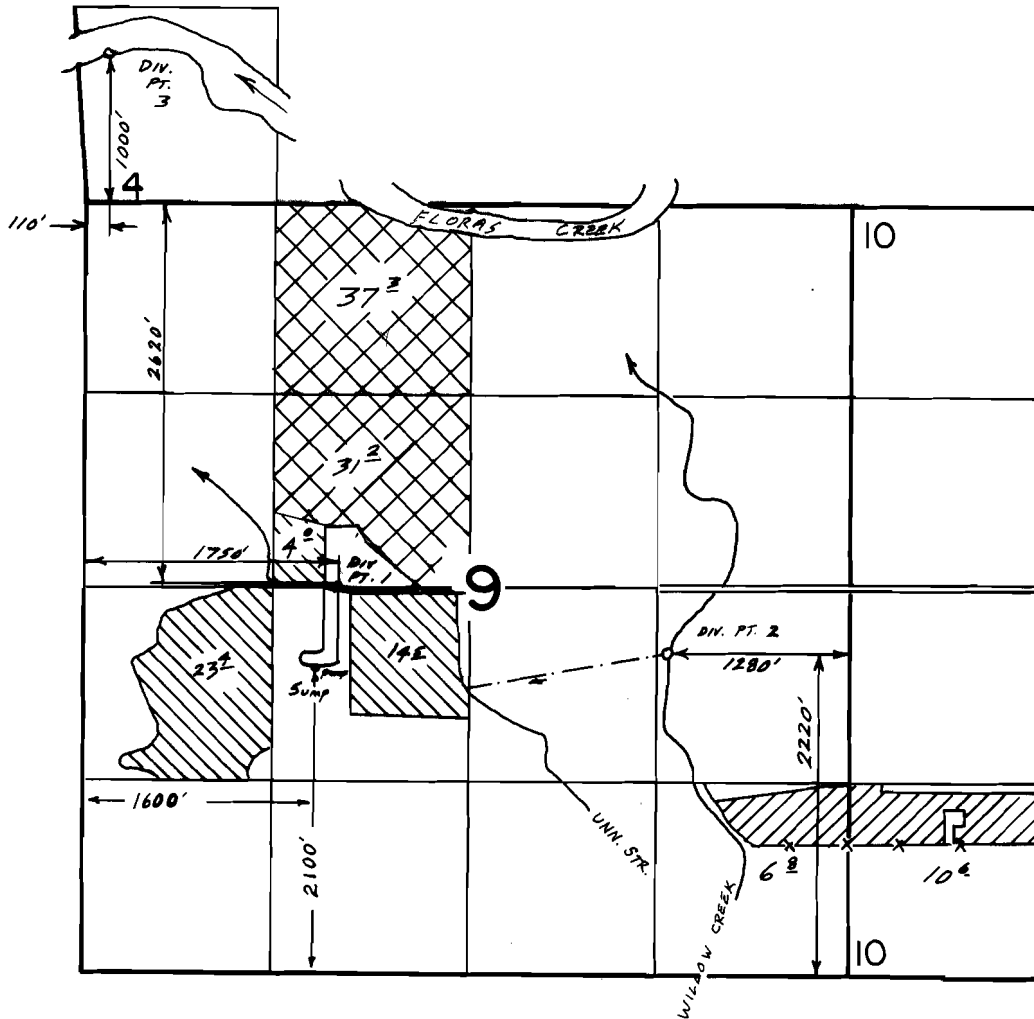

Scale 1" = 1320'

FINAL PROOF SURVEY UNDER

-  UNN. STR. (PRI) SUMP & WILLOW & FLOAS CRK (SUPP)
-  WILLOW CRK (PRI)
-  UNN STR. (SUPP)

G-10531 G-9831

Application No. ~~62409~~ Permit No. 46891.....

IN NAME OF

.....ALAN.....ARTHUR.....HAGA.....

Surveyed June 27, 1988, by B.S. JAMES.....