


T. 8S., R. 46E., W.M.

RECEIVED

JUL 13 1992

WATER RESOURCES DIV.
SALEM, OREGON

THE PURPOSE OF THIS MAP IS FOR IDENTIFYING THE LOCATION
OF THE WATER RIGHT ONLY AND IS NOT INTENDED TO PROVIDE
LEGAL DIMENSIONS OF PROPERTY OWNERSHIP LINES.

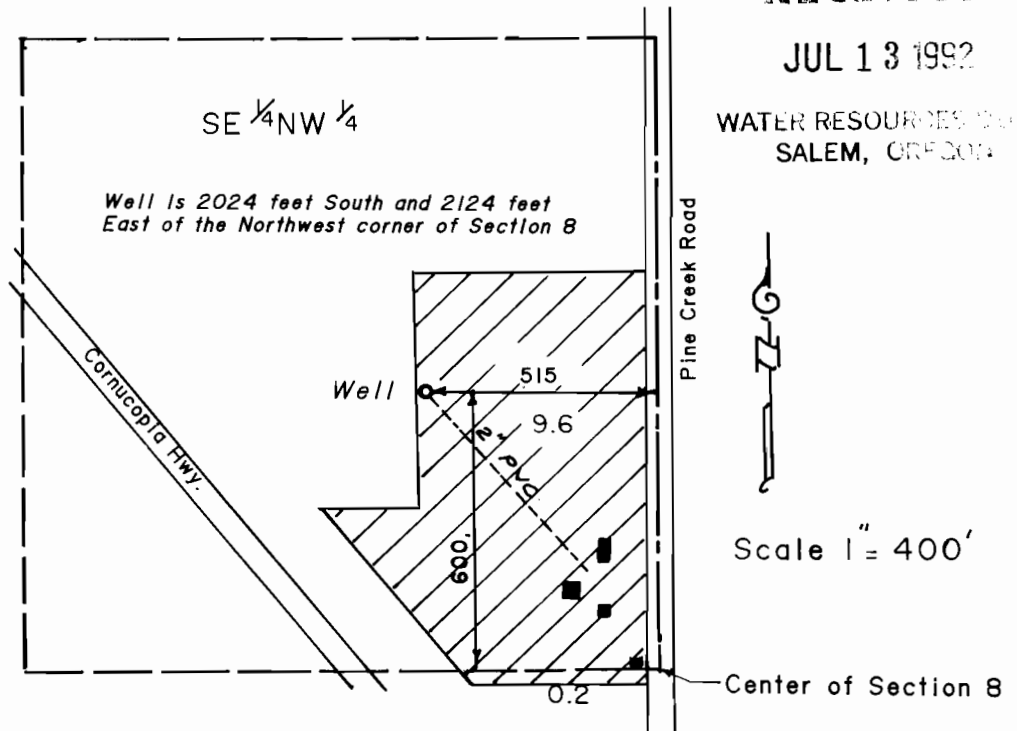

FINAL PROOF SURVEY

UNDER

Application No. G-11683 Permit No. G-10771

IN NAME OF

BILLIE HOWARD

Surveyed Sept. 21, 1991

