



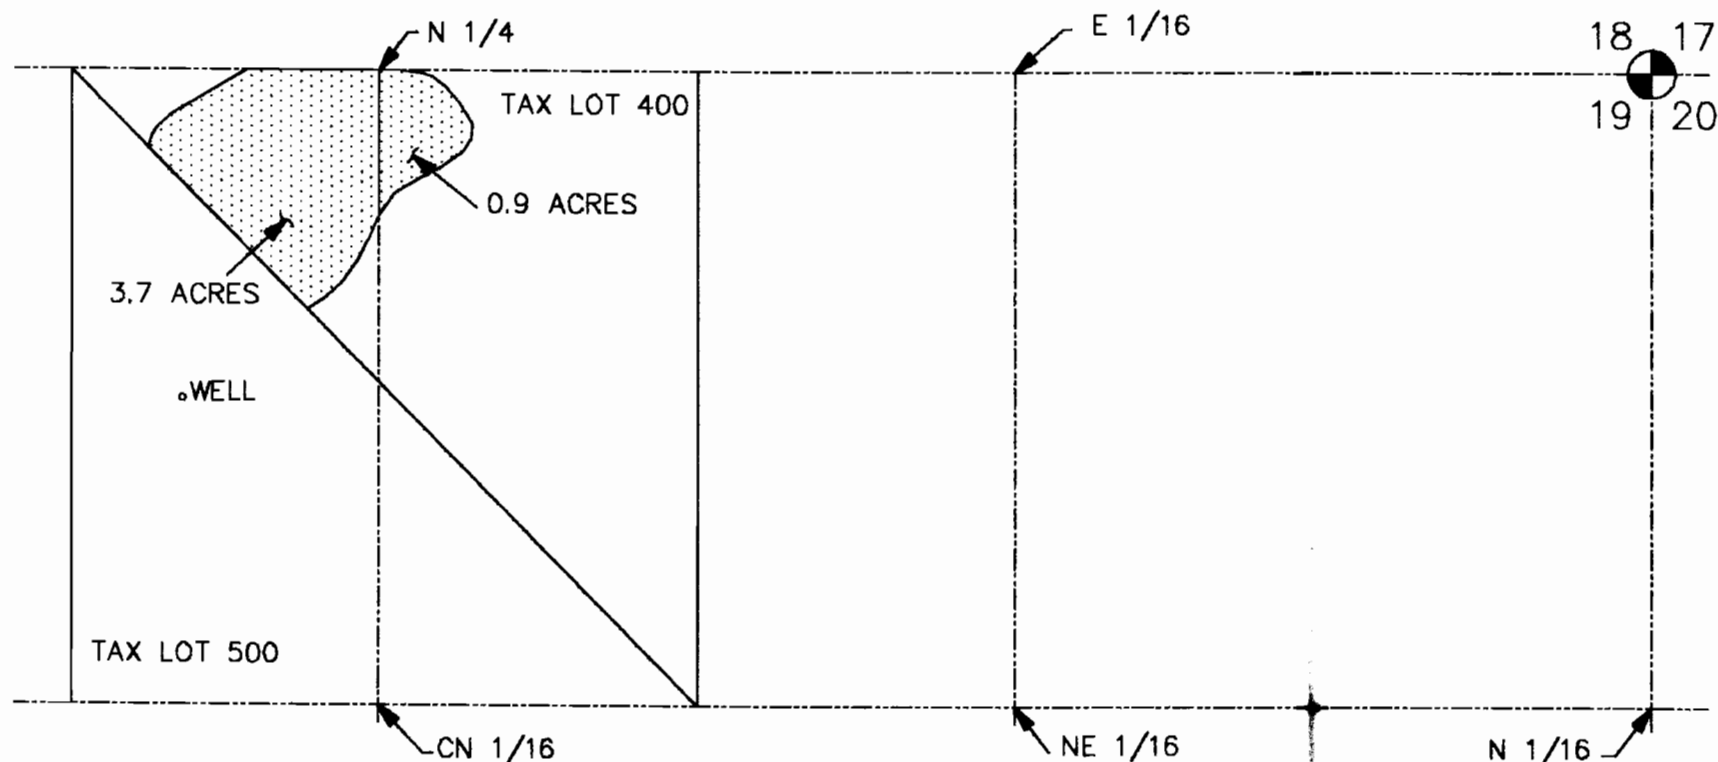

PERMIT NO. G-11368
APPLICATION NO. G-12588

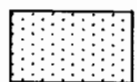


IRRIGATED AREA

I, Heidi L. Lansdowne, Certified Water Right Examiner
in the State of Oregon, hereby certify the above
final proof map was prepared under my direct
supervision.

The preparation of this map is for the purpose
of identifying the location of the water right only
and has no intent to provide dimensions or locations
of property ownership lines.

TAX LOT 400,
SECTION 19, T 16 S,
R 11 E, W.M., DESCHUTES
COUNTY, OREGON

THE WELL IS LOCATED 670 FEET SOUTH
AND 230 FEET EAST OF THE NORTHWEST
CORNER OF THE EAST HALF OF THE NORTHEAST
QUARTER OF THE NORTHWEST QUARTER OF
SECTION 19, T16S, R11E, W.M., DESCHUTES
COUNTY, OREGON

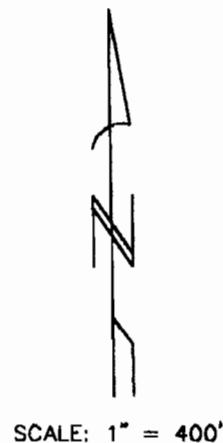

FINAL WATER RIGHTS SURVEY FOR:

FRANK CIBELLI
65525 SISEMORE ROAD
BEND, OR. 97701

LANDSDOWNE ENGINEERING

1012 NW WALL, SUITE 200, BEND, OREGON 97701 (503)389-9060

SCALE: 1" = 400'

DATE: 20 NOV 1991

DRAWN: HLL

FILE: FRANKF