


T. 25 S., R. 6 W., W. M.

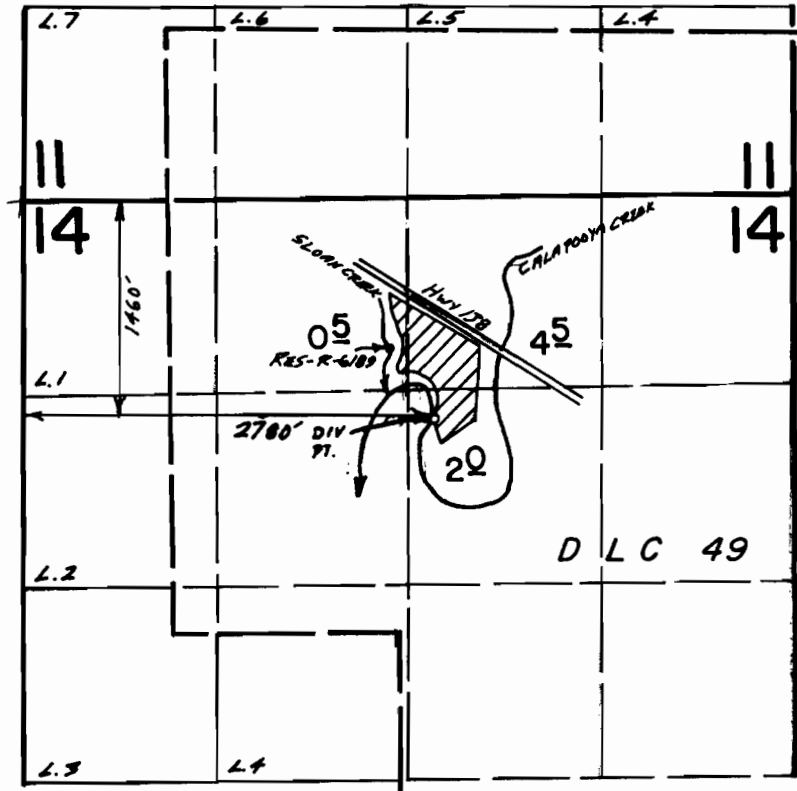

Scale : 1" = 1320'

**FINAL PROOF SURVEY
UNDER**

Application No. 50820 Permit No. 38368....
IN NAME OF

.....SHIRLEY.....CAIRNS.....

Surveyed July.23,1986, by M.Schmorde..
Sept.19,1991 by S. James
Oct.1,1991 by S. James