


T. 25 S., R. 6 W., W. M.

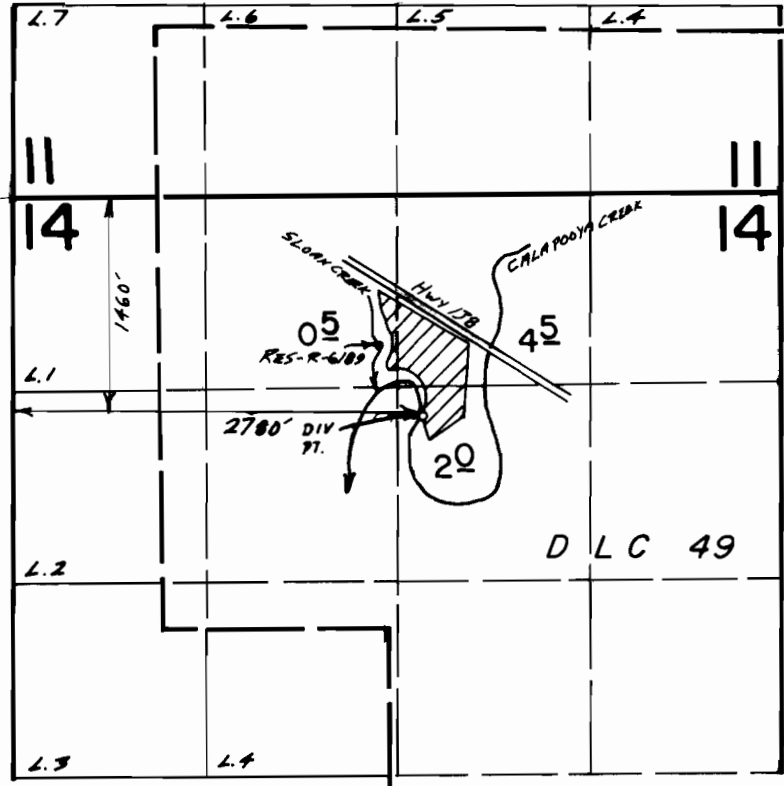

Scale : 1" = 1320'

**FINAL PROOF SURVEY
UNDER**

Application No. 50820 Permit No. 38368....
IN NAME OF

.....SHIRLEY.....CAIRNS.....

Surveyed July. 23, 1986, by M. Schmorde..
Sept. 19, 1991 by S. James
Oct. 1, 1991 by S. James