


T. 38 S., R. 2 W., W. M.

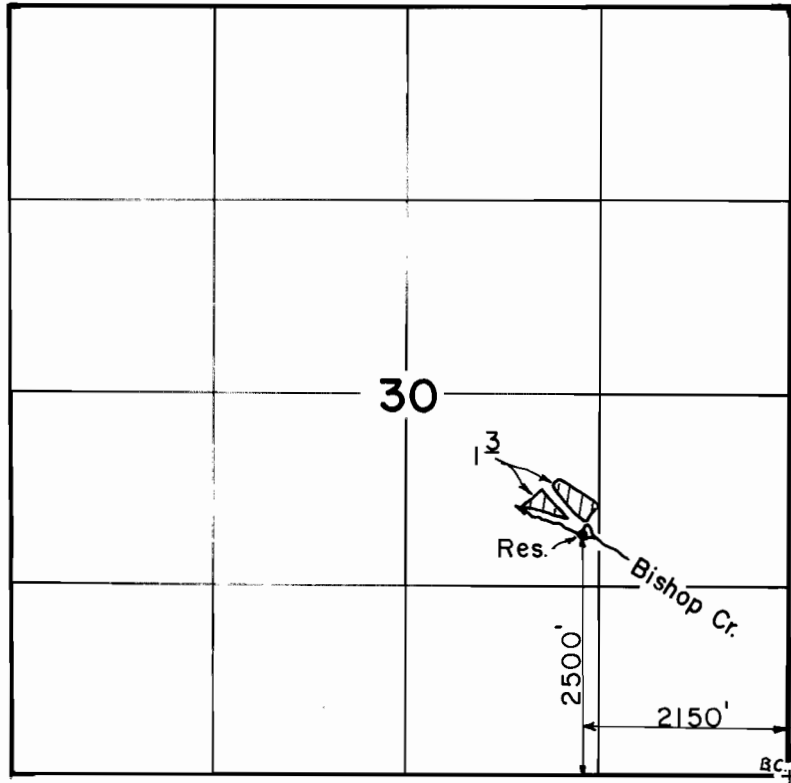

Scale: 1" = 1320'

FINAL PROOF SURVEY
UNDER

R-51728

R-6261

Application No. 51729 Permit No. 39127.....

IN NAME OF

JAMES.....W.....CHRISTOPHERSON

Surveyed OCT. 15. 1991., by B. S. JAMES....