


T.37S., R.8W., W.M.

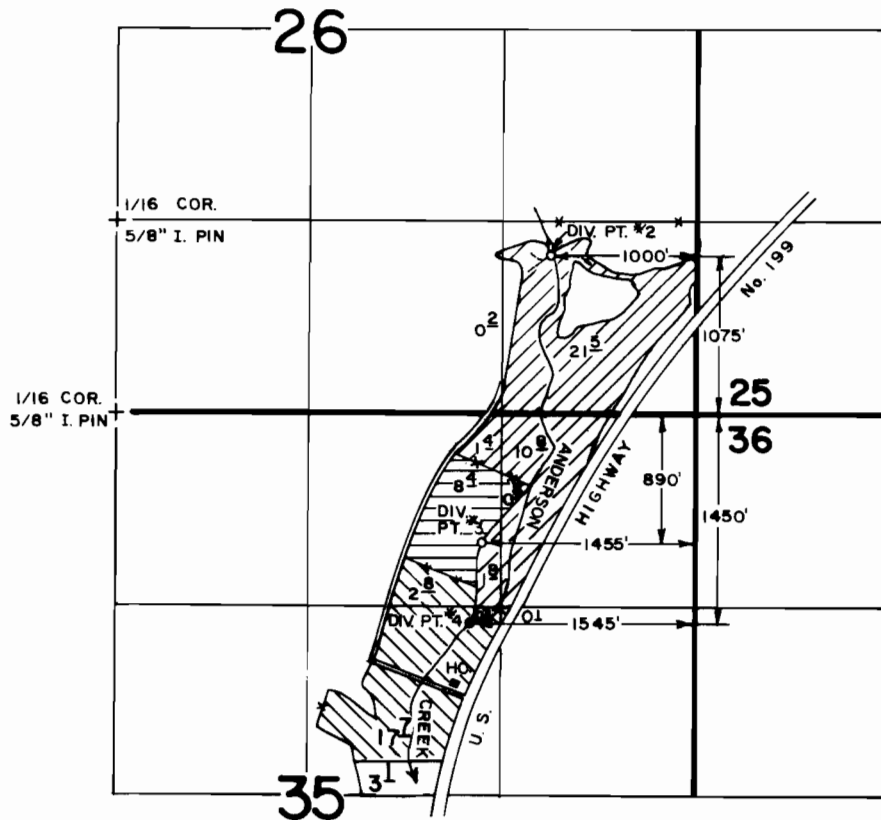




FINAL PROOF SURVEY UNDER

Application No. 52097 Permit No. 39252.....
IN NAME OF

HARRY & LINDA CRAWFORD

Surveyed NOV. 10, 1983, by B. SUZIE JAMES.

SCALE: 4" = 1 MILE

-  DIV. PT. #2
-  DIV. PT. #3
-  DIV. PT. #4

179-195L
JO. CO. 20-17-36 TWB

7/70 BSJ
8/92 by j