


T. 30S., R. 2 W., W.M.

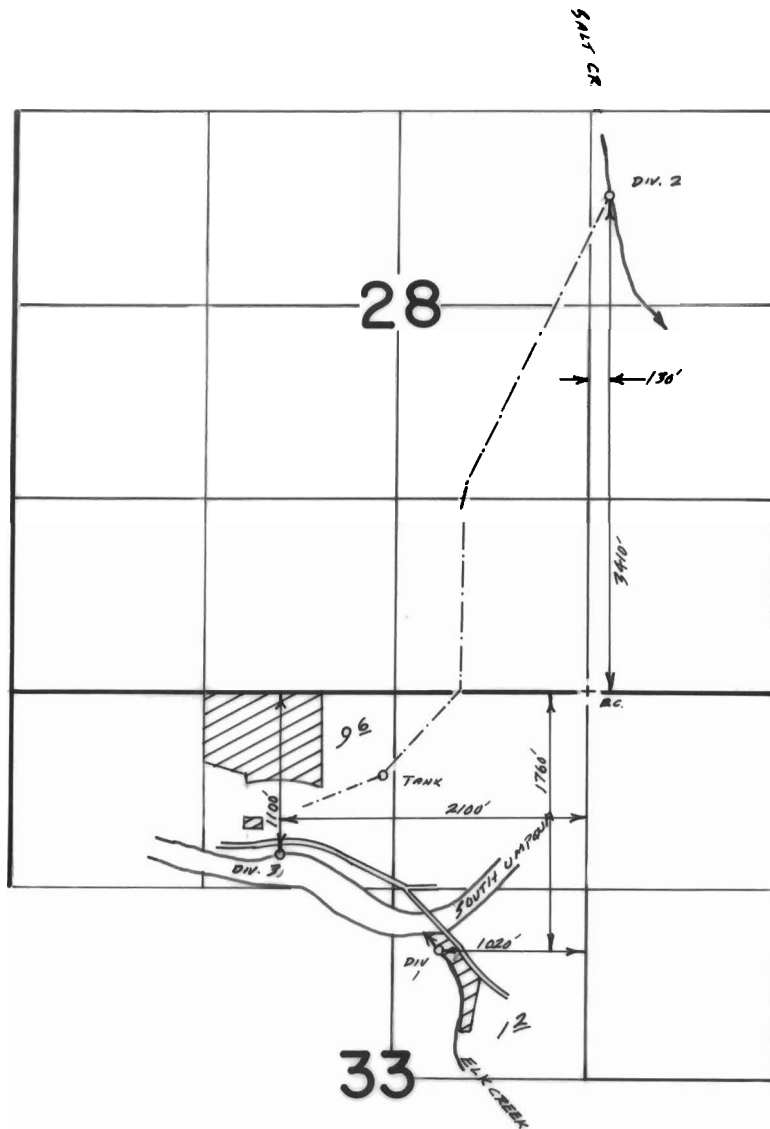

FINAL PROOF SURVEY
UNDER

Scale : 1" = 1320'

Application No. 59385 Permit No. 44699....
IN NAME OF

.....JANE.....PORTER.....

Surveyed Nov. 13., 1990., by S. James.....