


NE 1/4 Section 12

T5S., R.33 E.W.M.

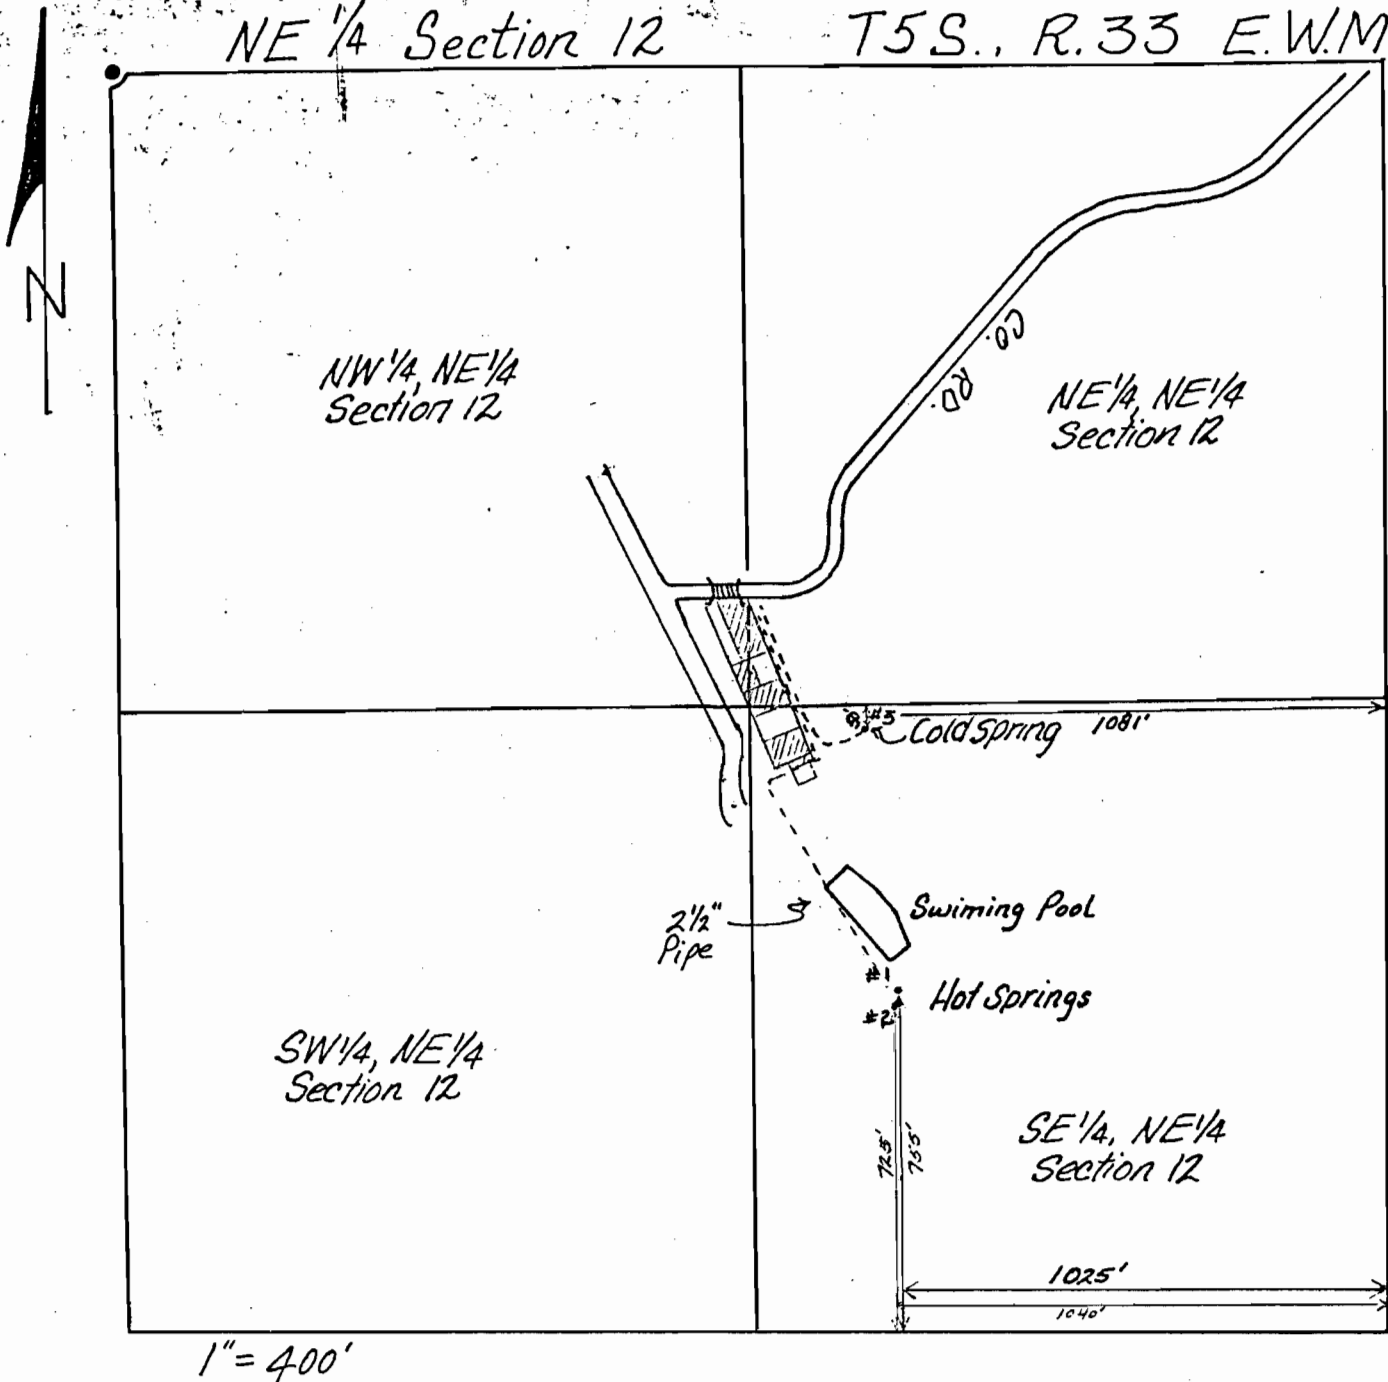


Application No. 68798
Permit No. 49856

RECEIVED
JUL 23 1986
WATER RESOURCES DEPT
SALEM, OREGON

T. 5 S., R. 33, E. W. M.
 Section 12




$\frac{21}{11\frac{1}{2}}$

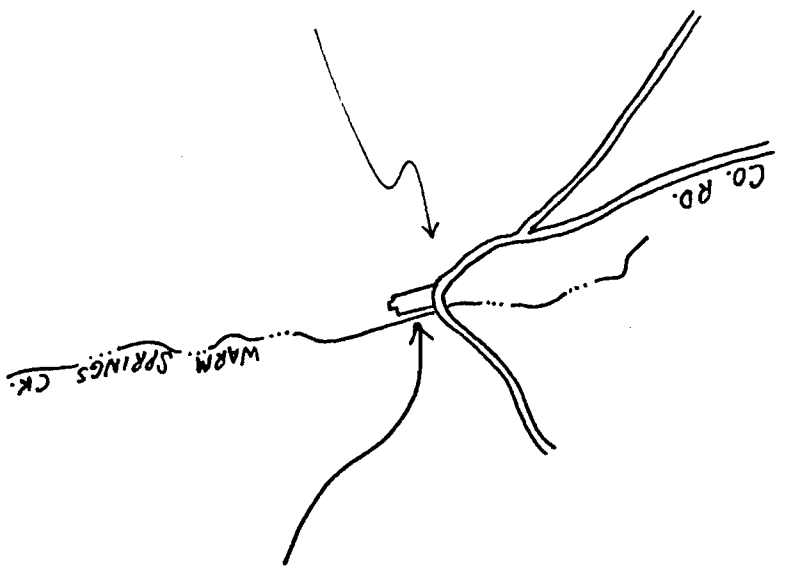

Five cabins subject to
 group domestic application

- #1: Kilgore
- #2: Macovey
- #3: A. M. McCormack
- #4: G. Simpson
- #5: R. M. McCormack

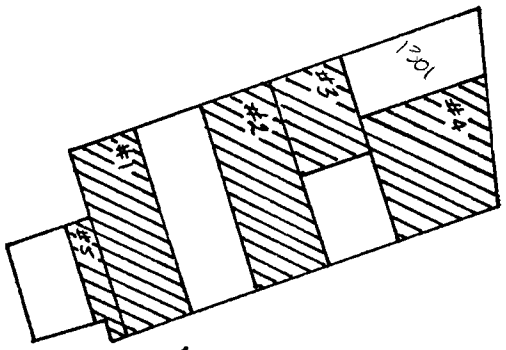

Application No. 68798
 Permit No. 49856