
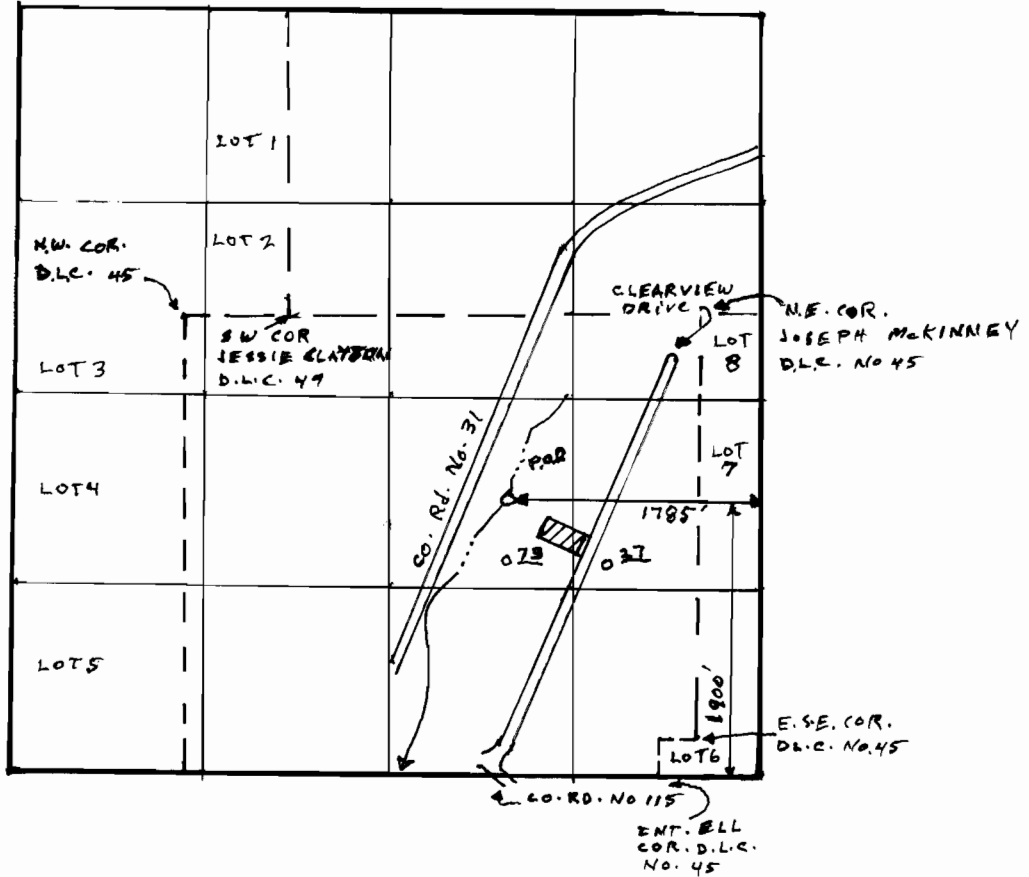


T.26S.,R.6W.,W.M.


SECTION 14

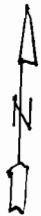

SCALE 1" = 1320'

FINAL PROOF SURVEY

UNDER

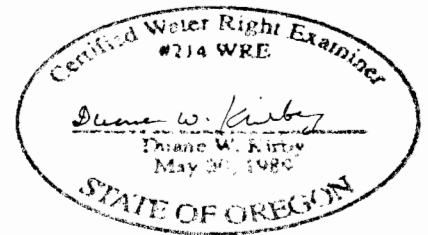

THE PURPOSE OF THIS MAP IS TO IDENTIFY THE LOCATION OF THE WATER RIGHT. IT IS NOT INTENDED TO PROVIDE INFORMATION RELATIVE TO THE LOCATION OF PROPERTY OWNERSHIP BOUNDARY LINES.

Application NO, 69407 Permit NO, 50265
IN NAME OF

RICHARD L. MEREDITH

Surveyed APRIL 25, 1992, by D. W. KIRBY

T 5259