


RECEIVED

SEP 30 1991

WATER RESOURCES DEPT.
SALEM, OREGON

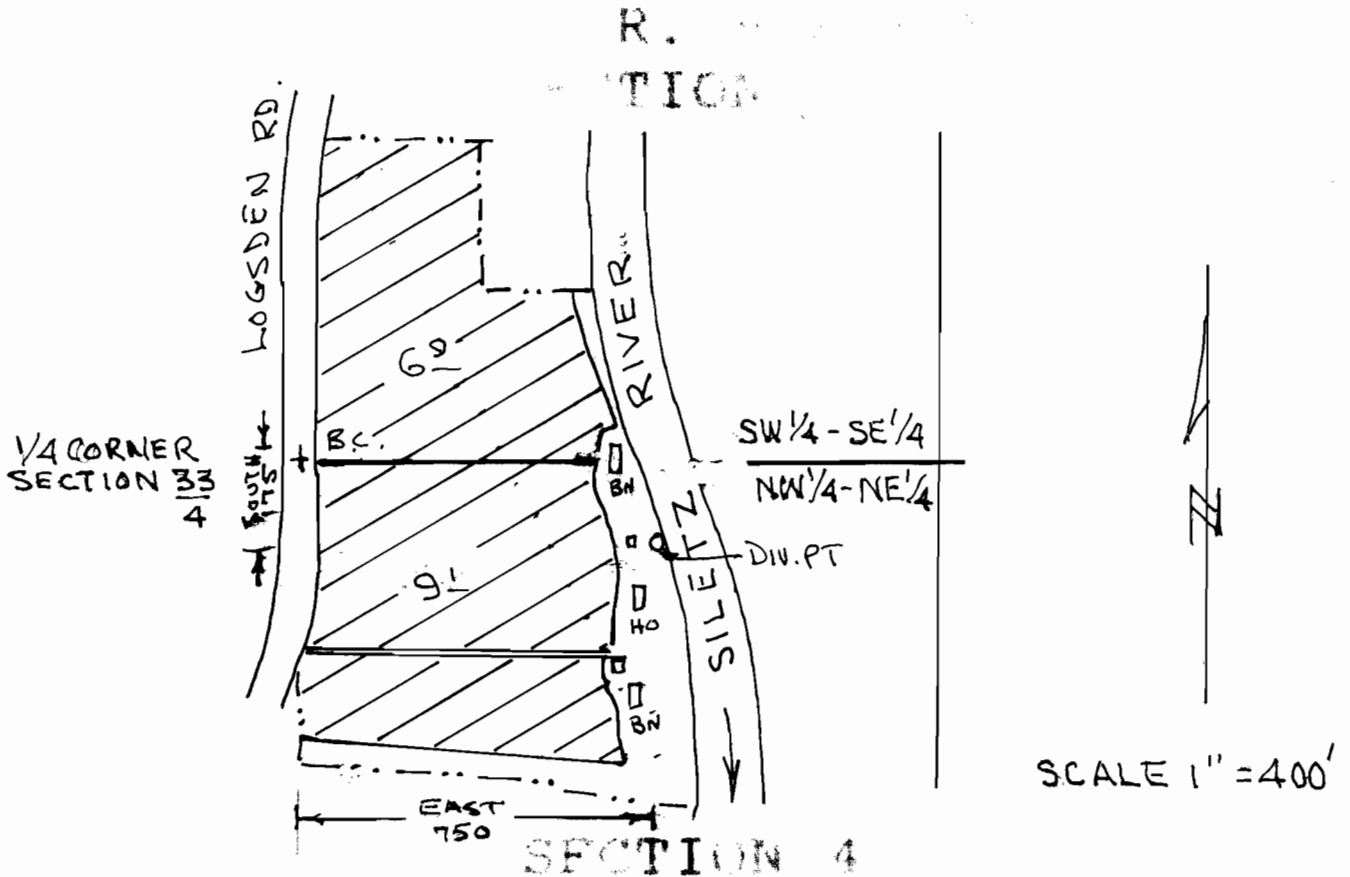

SECTION 4




FINAL PROOF SURVEY
UNDER

ANTHONY DILLER

