

Map of
WATER PERMIT SURVEY

in Sec. 35 T.28S R.13W. W.M.

For

NETTIE HALTER

Scale 1" = 500'

~ June 1926 ~

E.L. Vinton

N

27

26

26


25

34

35

35

36

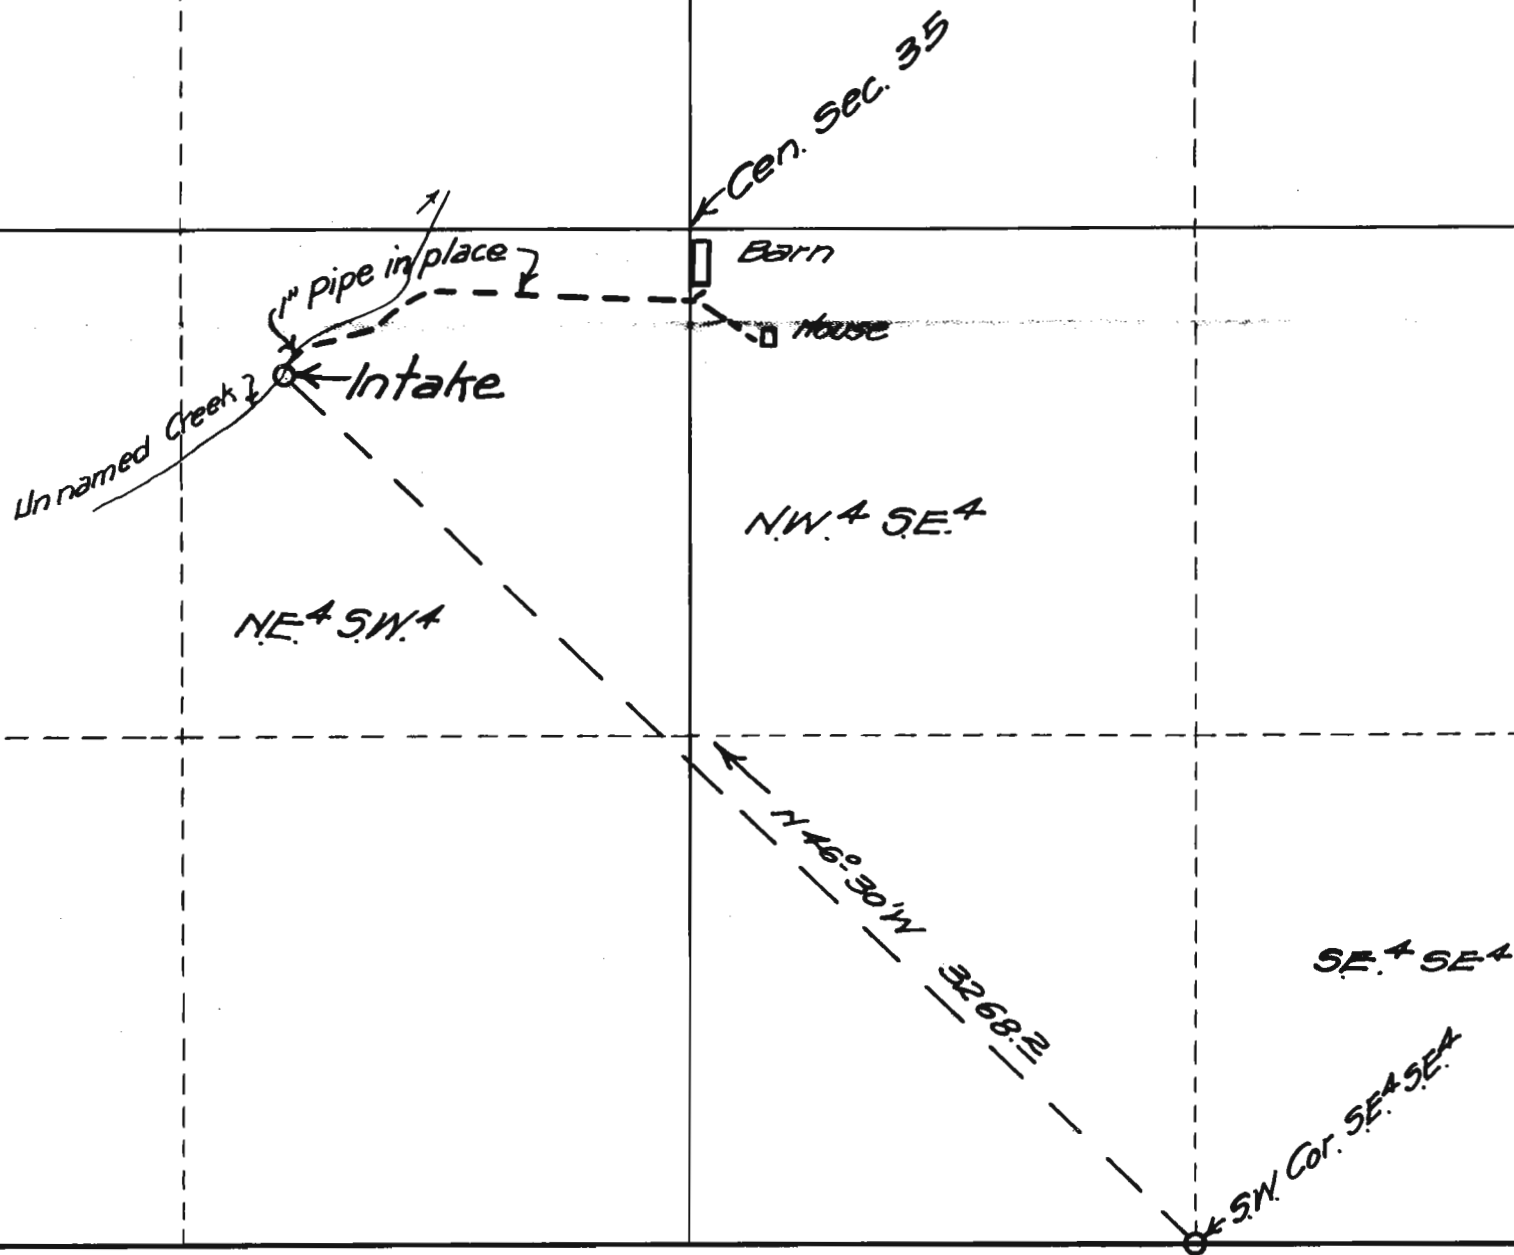

STATE ENGINEER
RECEIVED

JUN 2 1926

COQUILLE OREGON

34

35

35

36

3

2

2

1

I, E.L. Vinton, of Coquille Oregon, do hereby certify that this map was made from notes taken during an actual survey made by me on June 26 1926, and that it correctly represents the works described in the accompanying application, together with the location of streams and other ditches in the immediate vicinity.

Oregon No 164,
date of registration - Nov. 8 - 1919

E.L. Vinton
Registered Professional Engineer

Application No. 10863
Permit No. 7424