


T. 3 S. R. 2 W. W.M.

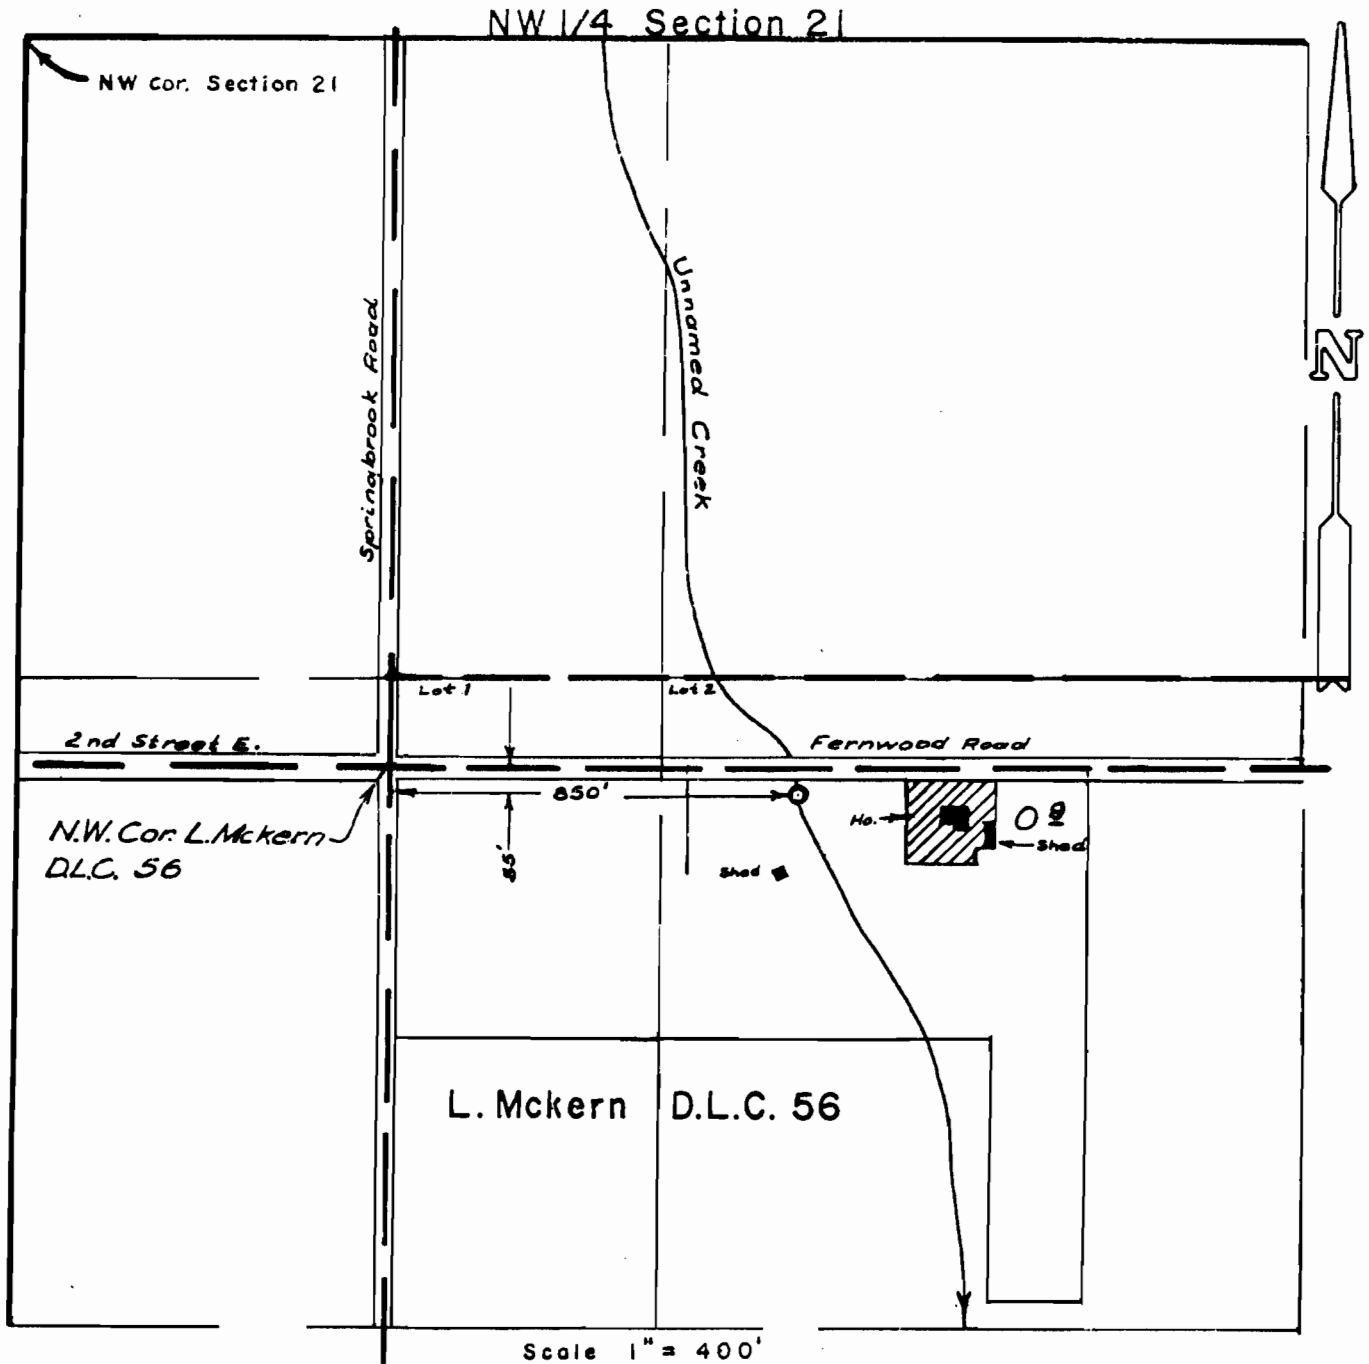

CLAIM OF BENEFICIAL USE
FOR

LAWRENCE W. ANDERSON

Application No. 69685 Permit No. 50638

THE PREPARATION OF THIS MAP IS FOR THE
PURPOSE OF IDENTIFYING THE LOCATION
OF THE WATER RIGHT ONLY AND HAS NO
INTENT TO PROVIDE DIMENSIONS OR LOCATION
OF PROPERTY OWNERSHIP LINES.

