


FINAL PROOF SURVEY T.40S., R.14W., W.M. S. 25 & 26

SCALE: 1" = 400 FT.

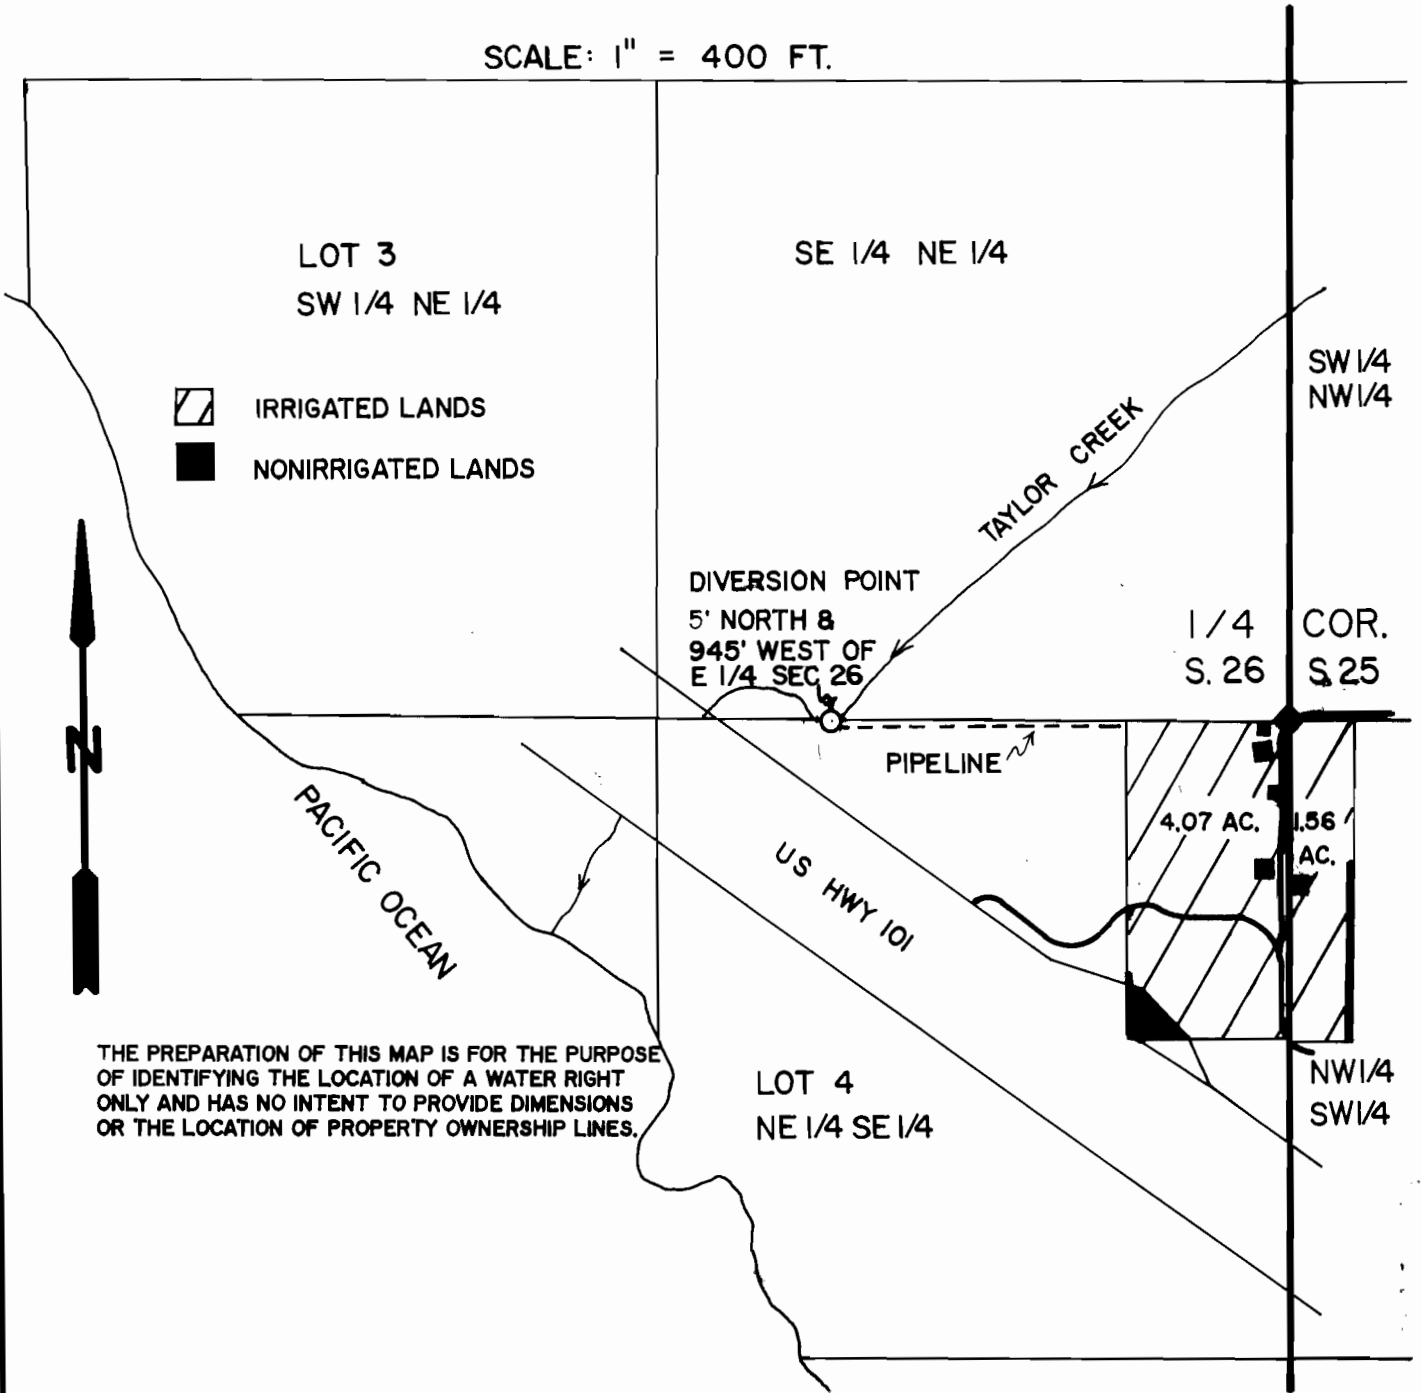

APPLICATION NO. 70015 PERMIT NO. 50835
IN THE NAME OF KELLY & DEBRA ITZEN

