
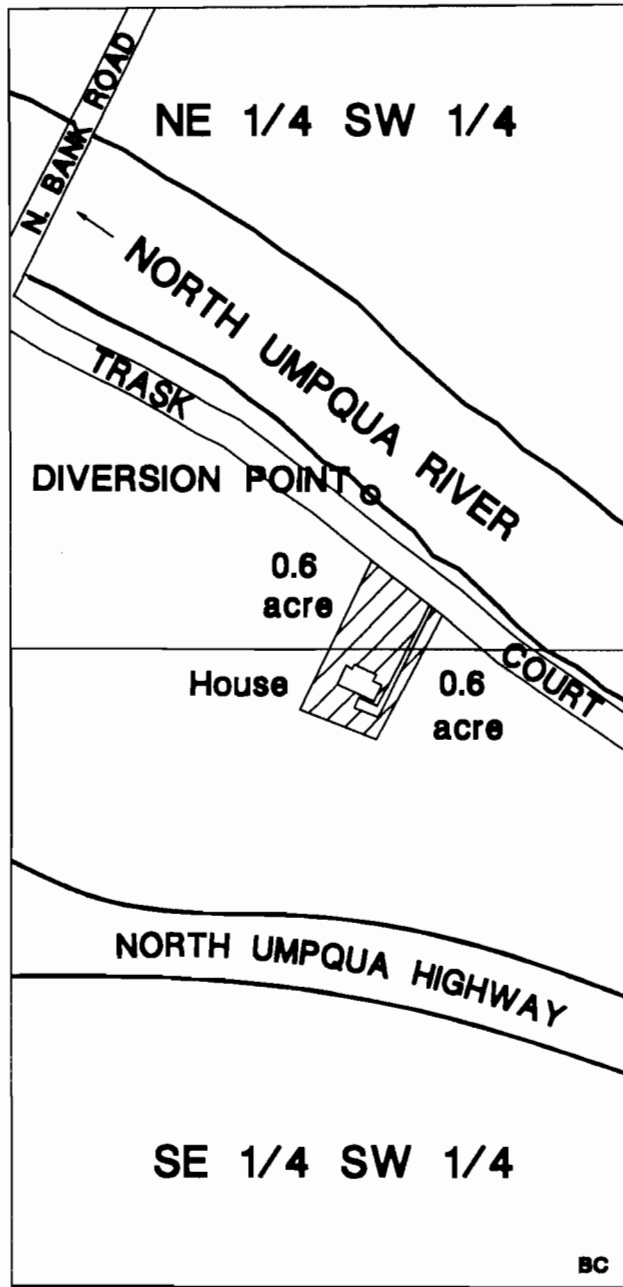


T. 26 S., R. 4 W., W.M., SECTION 13

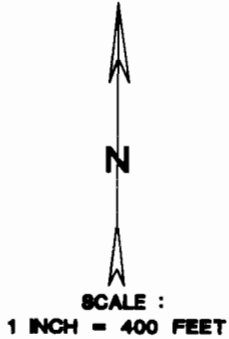

DIVERSION POINT IS 1660' N. & 540' W. FROM S1/4 COR. SEC. 13.

FINAL PROOF SURVEY MAP
FOR
HERBERT R. FORBESS
APPLICATION 70114
PERMIT 51063

THE PURPOSE OF THIS MAP IS TO IDENTIFY THE LOCATION OF THE WATER RIGHT. IT IS NOT INTENDED TO PROVIDE INFORMATION RELATIVE TO THE LOCATION OF PROPERTY OWNERSHIP BOUNDARY LINES.

