


T. 3N. R. 9 W. W.M.

THE PURPOSE OF THIS MAP IS TO IDENTIFY THE LOCATION OF THE WATER RIGHT. IT IS NOT INTENDED TO PROVIDE INFORMATION RELATIVE TO THE LOCATION OF PROPERTY OWNERSHIP BOUNDARY LINES.

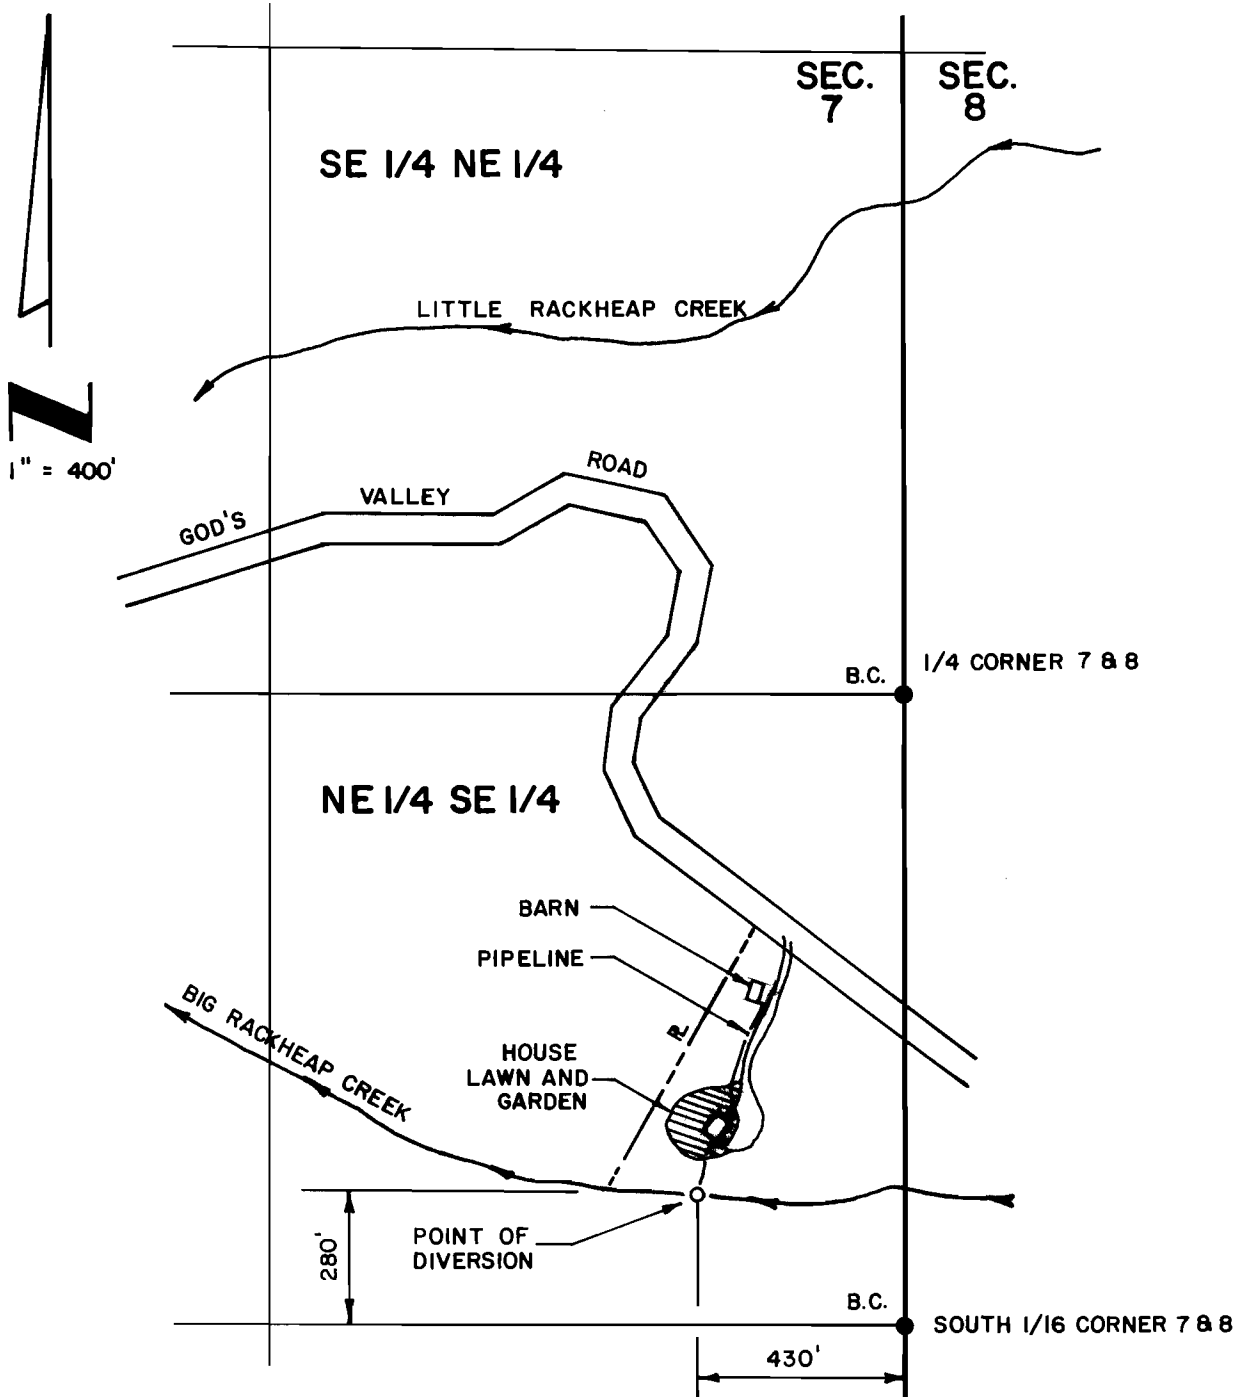

FINAL PROOF SURVEY
UNDER
APPLICATION NO. 70190 PERMIT NO. 51085
IN NAME OF
BLAINE AND DEBRA HUFFMAN
SURVEYED DEC. 12, 1991

