


# T.26S.R.3W. W.M.


## SECTION 29

SCALE 1" = 1320'

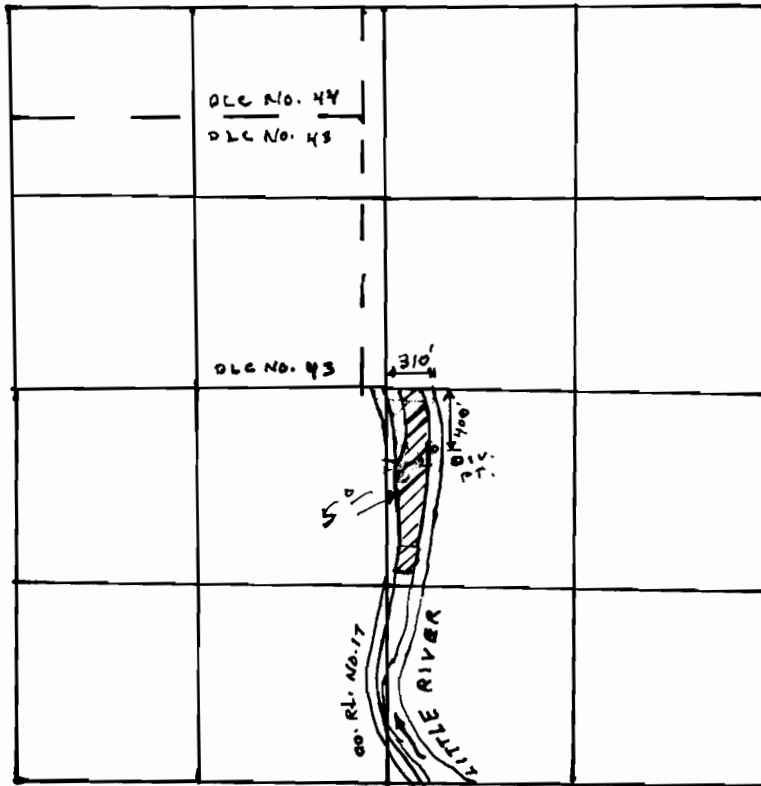

THE PURPOSE OF THIS MAP IS TO IDENTIFY THE LOCATION OF THE WATER RIGHT. IT IS NOT INTENDED TO PROVIDE INFORMATION RELATIVE TO THE LOCATION OF PROPERTY OWNERSHIP BOUNDARY LINES.

### FINAL PROOF SURVEY UNDER

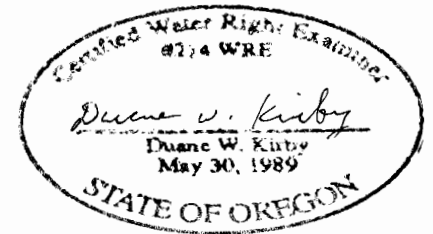

Application No. 70731 Permit No. 51384

IN NAME OF

JAMES A. BILDERBACK

Surveyed JUNE 14 1992 by DUANE KIRBY