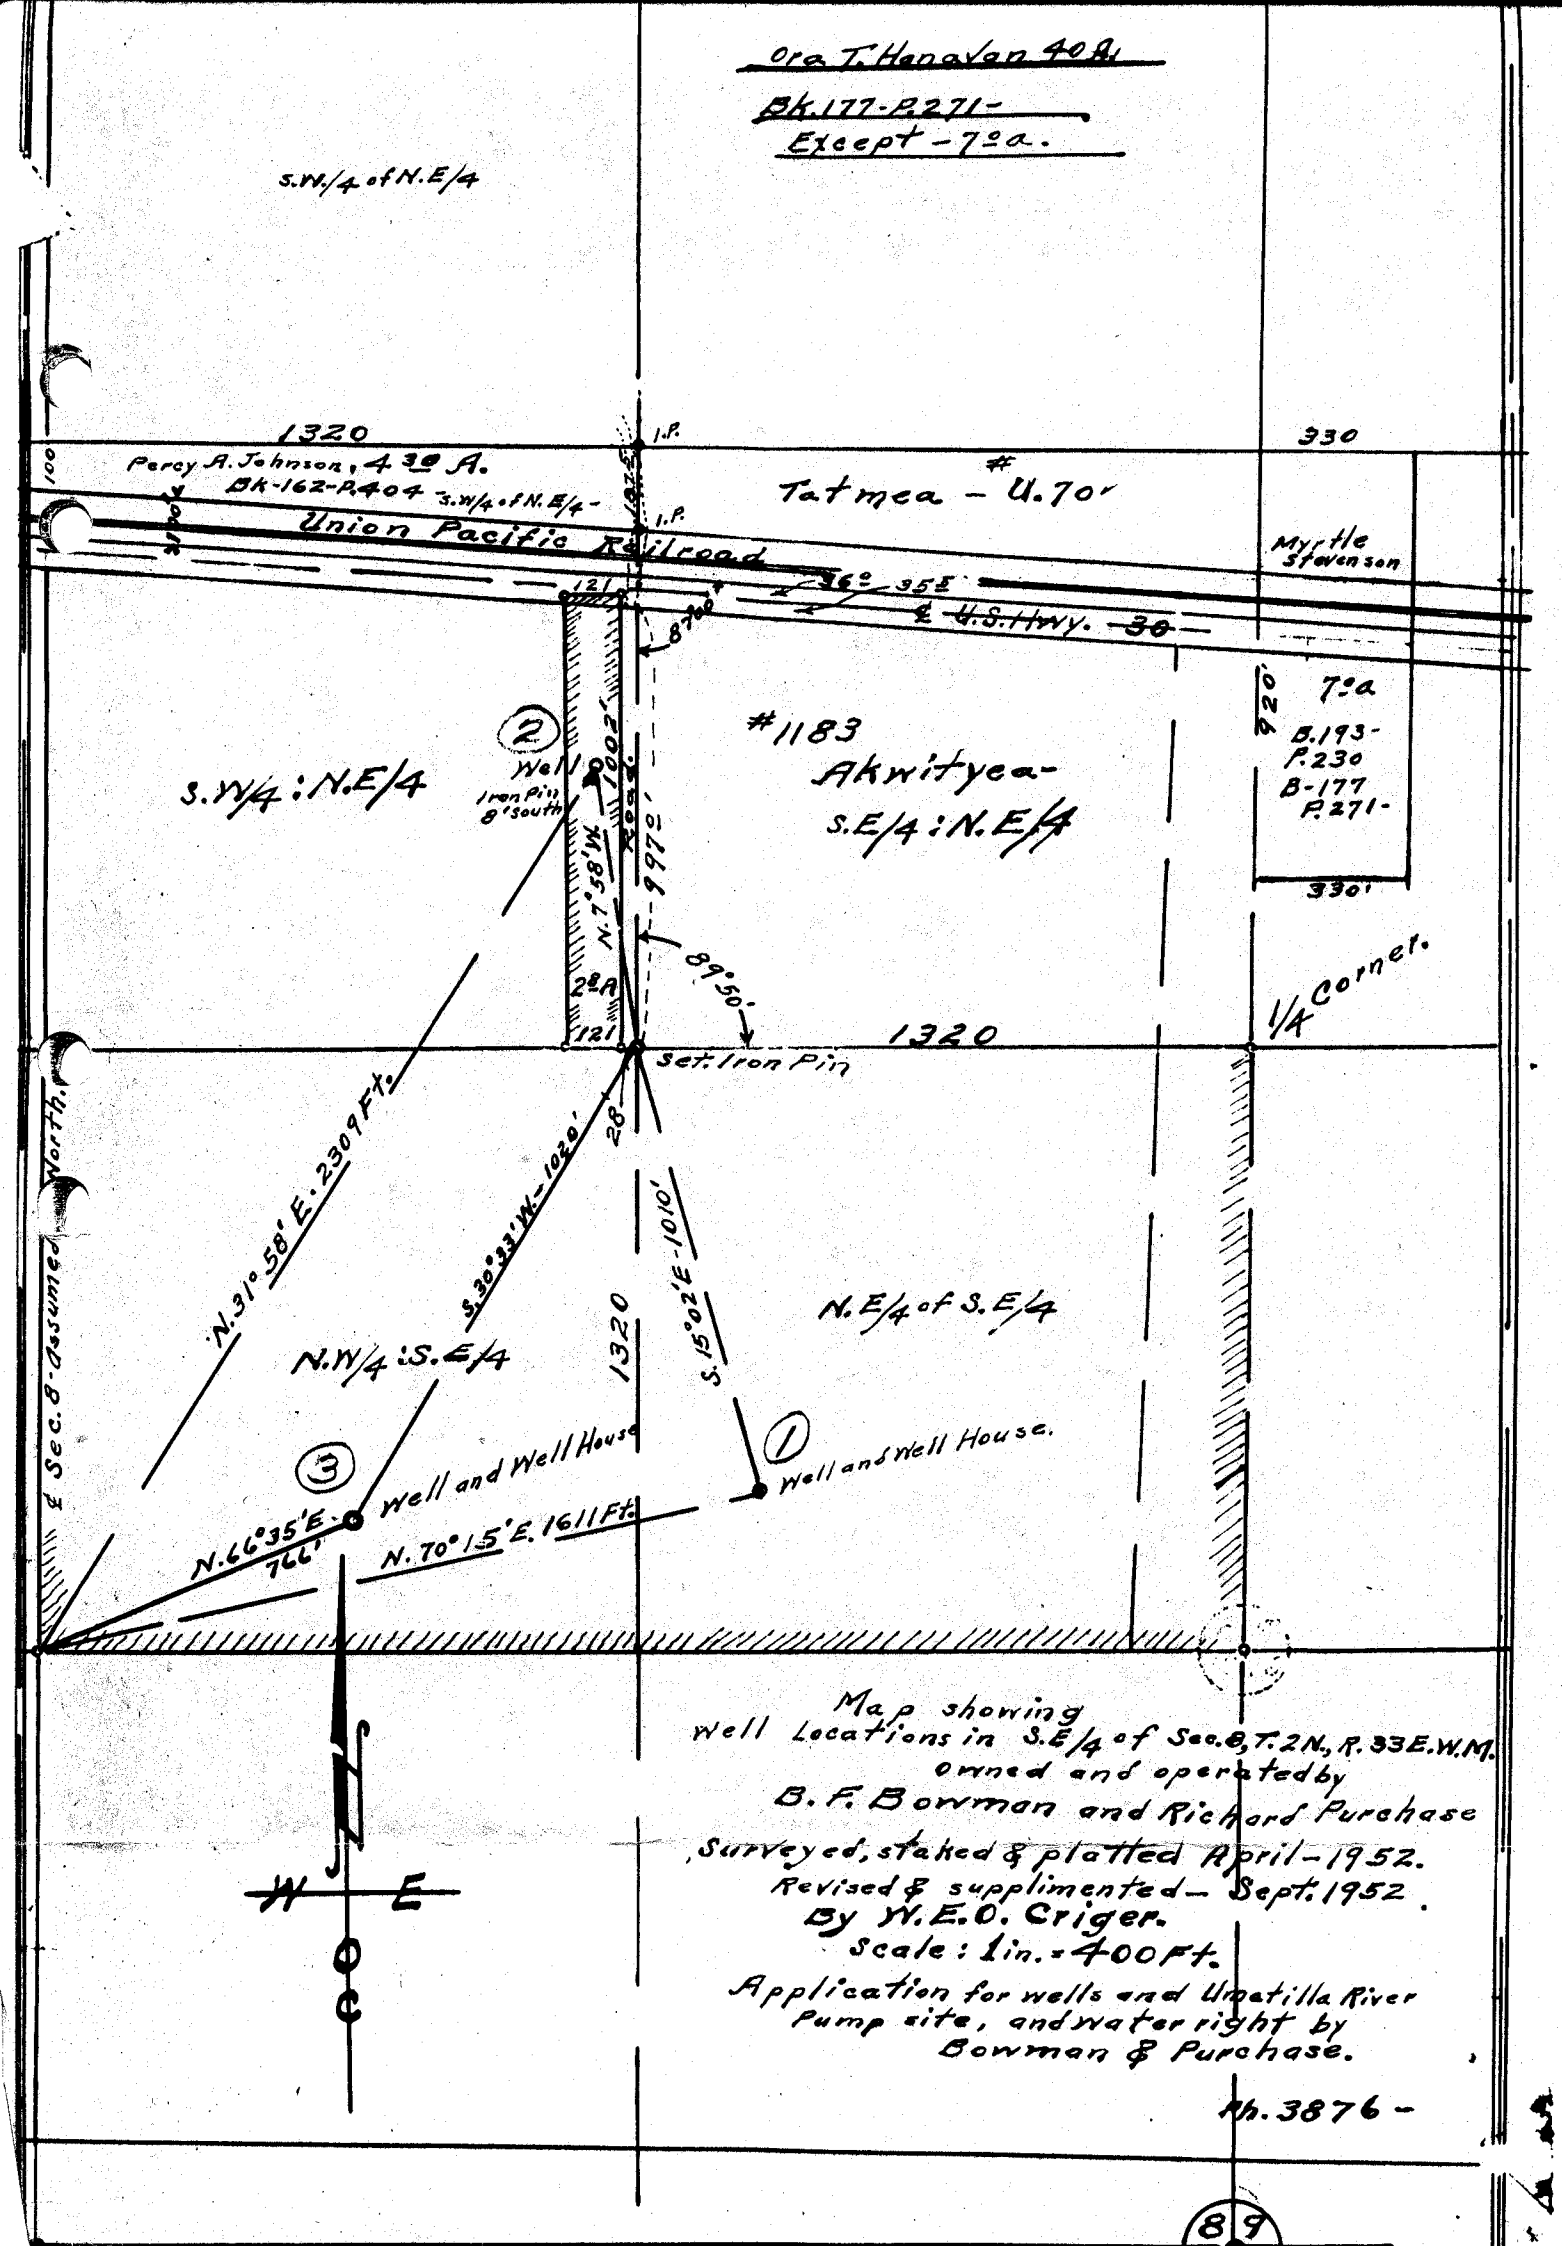

Map showing
Well Locations in S.E/4 of Sec. 8, T. 2N., R. 33E.W.M.
owned and operated by
B. F. Bowman and Richard Purchase
Surveyed, staked & platted April - 1952.
Revised & supplimented - Sept. 1952.
By W.E.O. Criger.
Scale: 1 in. = 400 Ft.

Application for wells and Umatilla River pump site, and water right by Bowman & Purchase.

Ap. 3876 -

8 9