


T. 3S. R. 26E. W.M.

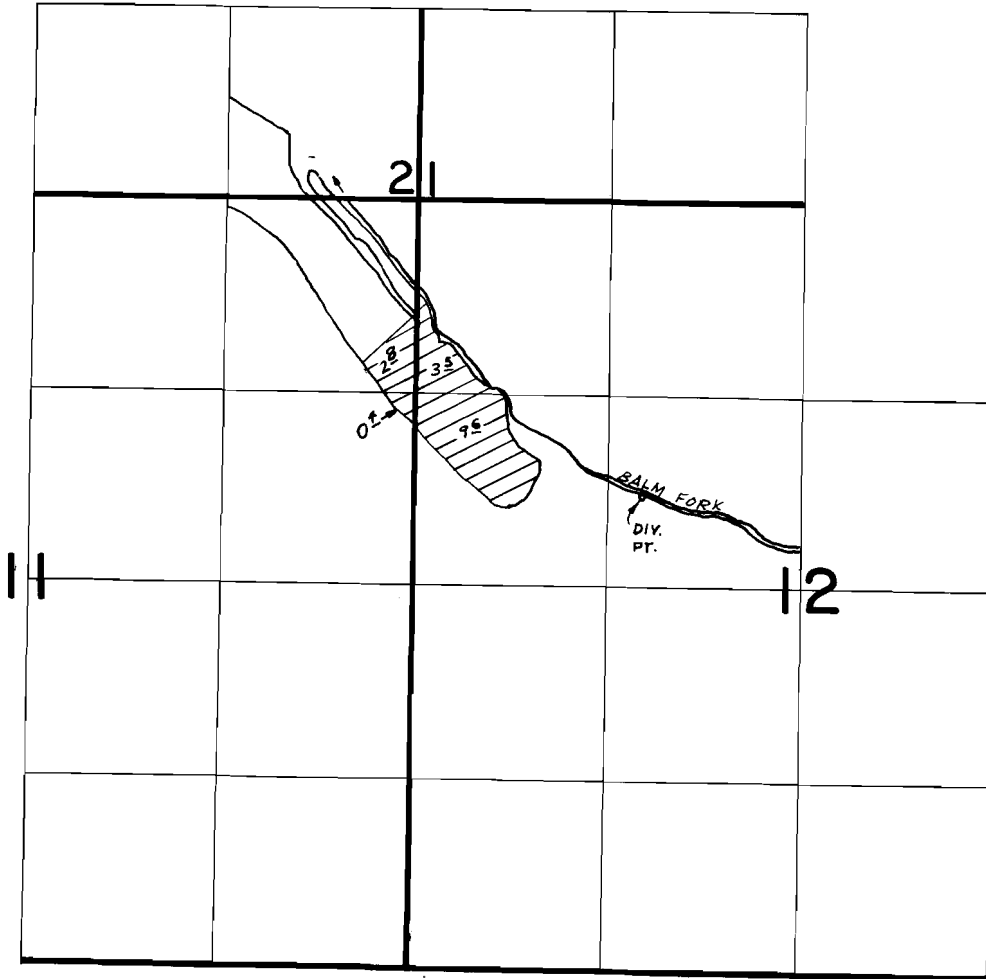

DIV. PT. LOCATED 2030'S & 1550'E FROM NW COR SEC 12

FINAL PROOF SURVEY
UNDER

Application No. 50027 Permit No. 37755
IN NAME OF

A. L. OSMIN

Surveyed 8-8 1978, by R. BARWIN