


# T. 40 S., R. 12 E., W.M.

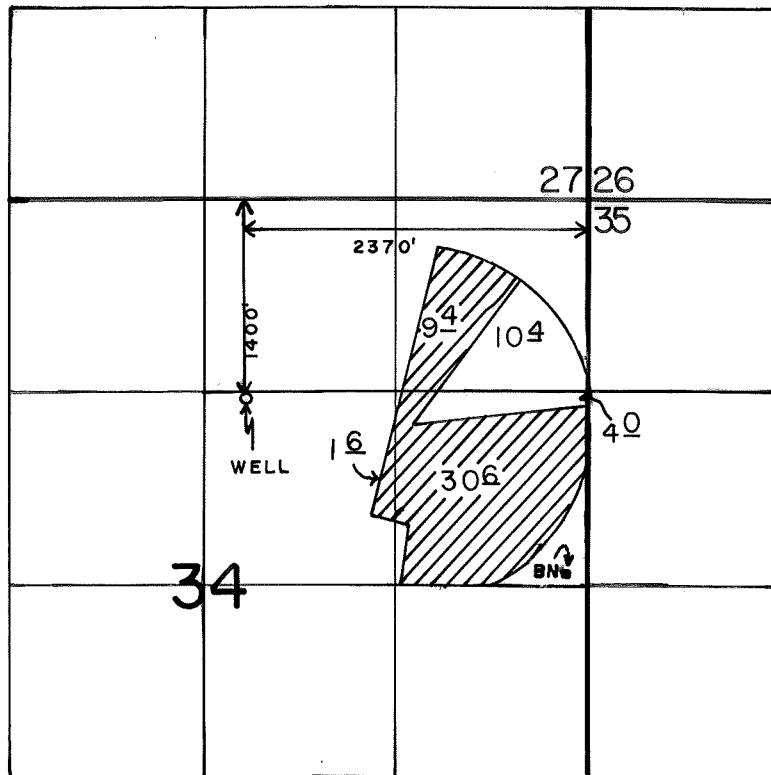

SCALE: 1" = 1320'

## FINAL PROOF SURVEY

UNDER

Application No. G-10804 Permit No. G-9937

IN NAME OF

NORTHWEST FARM CREDIT SERVICES, ACA  
MELVIN C. & VIRGINIA K. HENDRICKSON

Surveyed OCT 17, 1992, by B.W. BISHOP