

NW.1/4, NE.1/4

NE.1/4, NE.1/4

ROAD

SE.1/4, NE.1/4

SANDLIN

SW.1/4, NE.1/4

WELL #2
81 GPM

WELL #1
15 GPM

APPLES

TIMBER

RISERS

2" WATER

HOUSE

539'

18.5 AC.

CHERRIES

CHERRIES

GARDEN

SCRUB
OAK

319'

PRUNES

280'

E.1/4, SEC. 1,
R.R. SPIKE.

NW.1/4, SE.1/4

CHERRY HEIGHTS

NE.1/4, SE.1/4

RANGE 12 E.
RANGE 13 E.

FINAL PROOF SURVEY

SCALE: 1" = 400'

APPLICATION No. G-11715


PERMIT No. G10847

IN THE NAME OF:

RENATO G.B. VERGORI

DATE: SEPTEMBER 18, 1992

BY: TENNESON ENGINEERING CORP.
409 LINCOLN STREET,
THE DALLES, OREGON. 97058
PH. (503) 296-9177

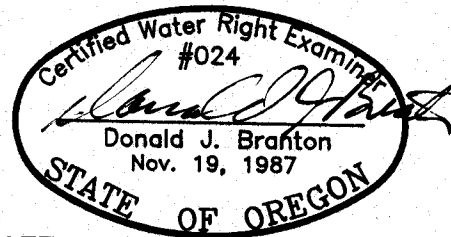


NOTE:

"THIS MAP IDENTIFIES THE LOCATION OF THE WATER RIGHT ONLY AND IS NOT INTENDED TO PROVIDE DIMENSIONS OR LOCATE PROPERTY OWNERSHIP LINES."

SECTION 1, TWP.1N. RANGE 12 E. W.M.
 WASCO COUNTY, OREGON

TWP. 2 N.
 TWP. 1 N.

36 31
 1 6

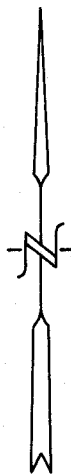

NW.1/4, NE.1/4

NE.1/4, NE.1/4

ROAD

SE.1/4, NE.1/4

SANGLIN

SW.1/4, NE.1/4

WELL #2
 81 GPM

WELL #1
 15 GPM

APPLES

TIMBER

RISERS

2" WATER

HOUSE

539'

18.5 AC.

CHERRIES

GARDEN

CHERRIES

1" SCRUB OAK

319'

PRUNES

280'

E.1/4, SEC. 1,
 R.R. SPIKE.

NW.1/4, SE.1/4

NE.1/4, SE.1/4

941'

CHERRY HEIGHTS

RANGE 12 E.

RANGE 13 E.

FINAL PROOF SURVEY

SCALE: 1" = 400'

APPLICATION No. G-11715

PERMIT No. G10847

IN THE NAME OF:

