


T. 36 S. R. 12 E. W. M.

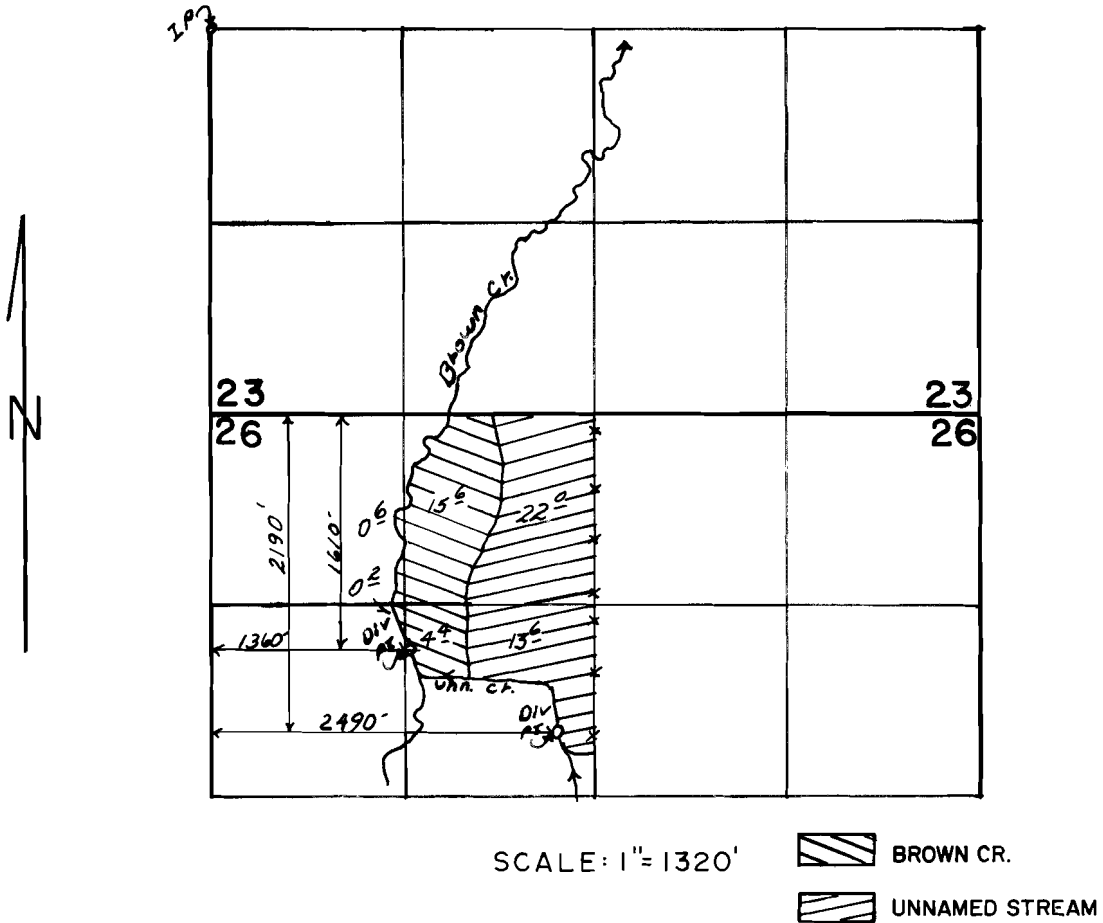

FINAL PROOF SURVEY
UNDER

Application No. 53829 Permit No. 40181
IN NAME OF

HOWARD K. & VICKI E. WILSON

Surveyed Nov. 25 1991, by D. Sparks