


T. 28 S., R. 12 W., W.M.

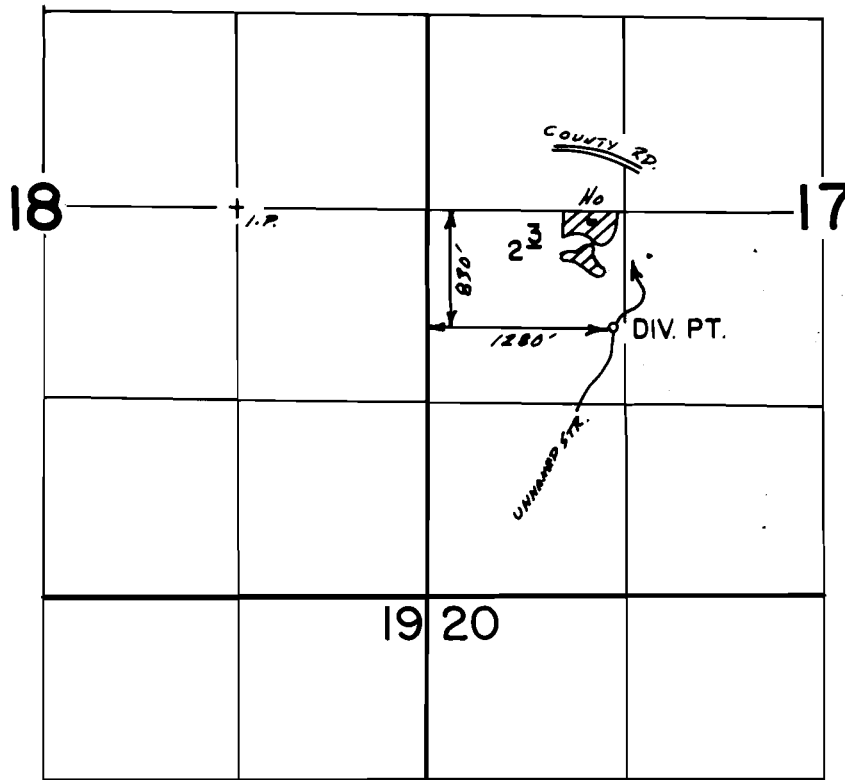

Scale : 1" = 1320'



FINAL PROOF SURVEY
UNDER

Application No. 54375 Permit No. 40752...
IN NAME OF

HARRY A. & JOAN H. SWEETMAN

Surveyed Oct. 12, 1983, by L.E. CASHION