


T. 28 S., R. 14 W., W.M.

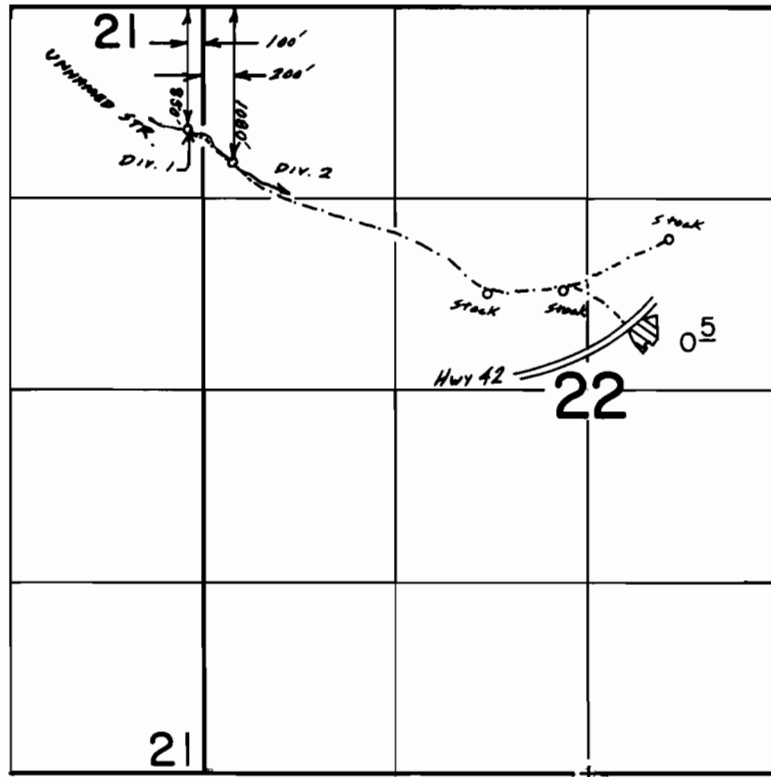

Scale 1"=1320'

**FINAL PROOF SURVEY**  
UNDER

Application No. 59787 Permit No. 46035...  
IN NAME OF

BARTOL...DOMENIGHINI, Jr.....

Surveyed Oct. 29, 1991..., by B.S. JAMES.....