



T.40S.,R14E.,W.M.

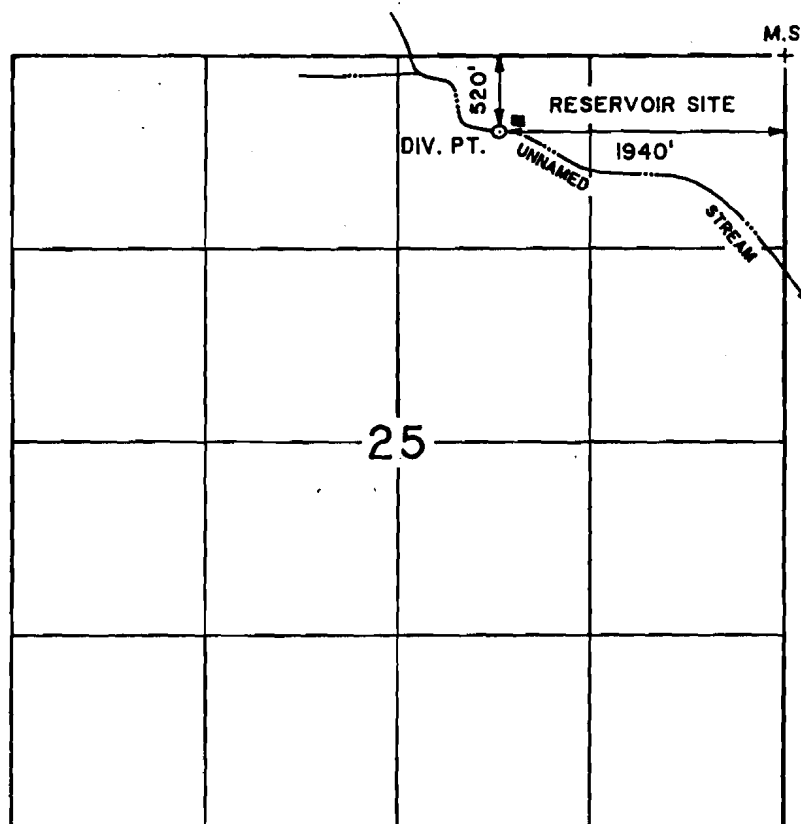

1" = 1320'

FINAL PROOF MAP

UNDER

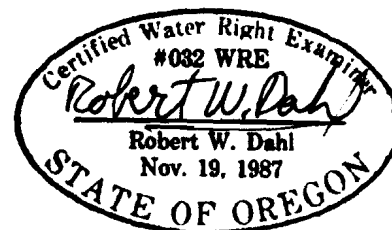

APPLICATION NO. R-69822 PERMIT NO. R-11070

IN NAME OF
UNITED STATES BUREAU OF LAND MANAGEMENT

SURVEYED SEPTEMBER 17, 1990

THE PURPOSE OF THIS MAP IS FOR IDENTIFYING THE LOCATION OF THE WATER RIGHT ONLY AND IS NOT INTENDED TO PROVIDE LEGAL DIMENSIONS OR LOCATION OF PROPERTY OWNERSHIP LINES.

BLM PROJECT NO. OR-010-6093

WRE 6006 OREGON

U.S. BUREAU OF LAND MANAGEMENT-OSO
BRANCH OF CADASTRAL SURVEY
LETTER OF AUTHORIZATION
DATED: SEPTEMBER 10, 1990

EXECUTED BY:
ROBERT W. DAHL, RLS, CWRE
P.O. BOX 1374
WALDPORT, OREGON 97394