



68149

T.40S.,R.14 1/2E.,W.M.

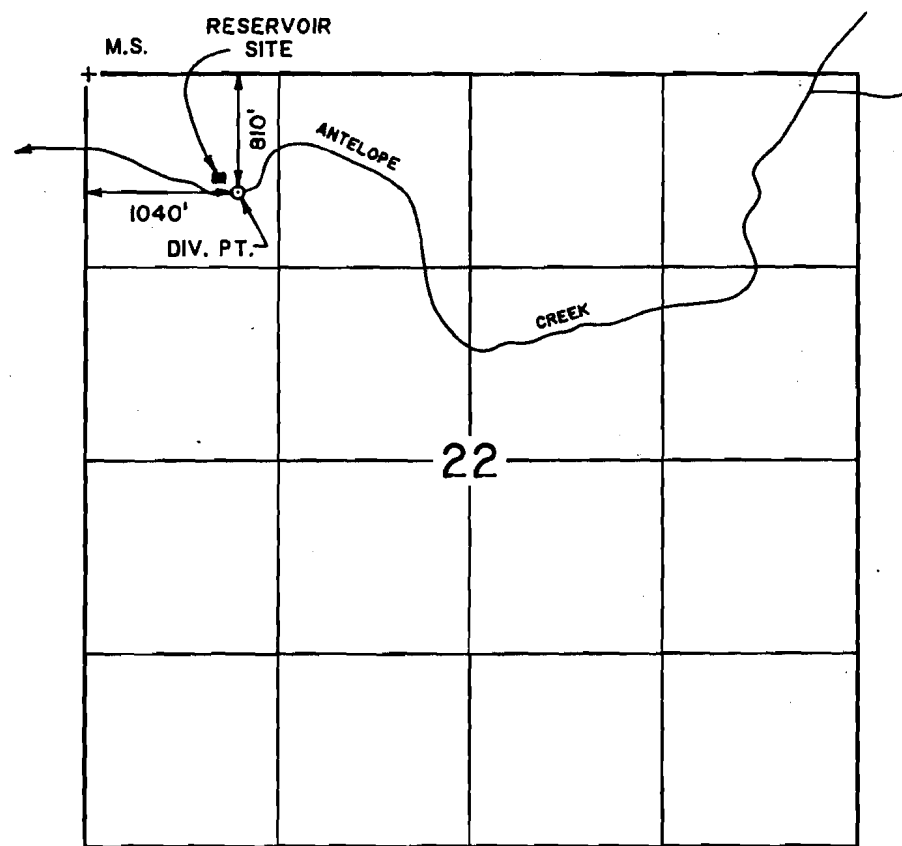

FINAL PROOF MAP
UNDER

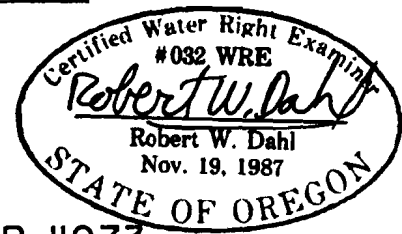

APPLICATION NO. R-69825 PERMIT NO. R-11073

IN NAME OF
UNITED STATES BUREAU OF LAND MANAGEMENT

SURVEYED SEPTEMBER 13, 1990

THE PURPOSE OF THIS MAP IS FOR IDENTIFYING THE LOCATION OF THE WATER RIGHT ONLY AND IS NOT INTENDED TO PROVIDE LEGAL DIMENSIONS OR LOCATION OF PROPERTY OWNERSHIP LINES.

BLM PROJECT NO. OR-010-6089

WRE 6002 OREGON

U.S. BUREAU OF LAND MANAGEMENT-OSO
BRANCH OF CADASTRAL SURVEY
LETTER OF AUTHORIZATION
DATED: SEPTEMBER 10, 1990

EXECUTED BY:
ROBERT W. DAHL, RLS, CWRE
P.O. BOX 1374
WALDPORT, OREGON 97394

E. Branch Lost River Mtn.