


T. 38 S., R. 2 W., W. M.

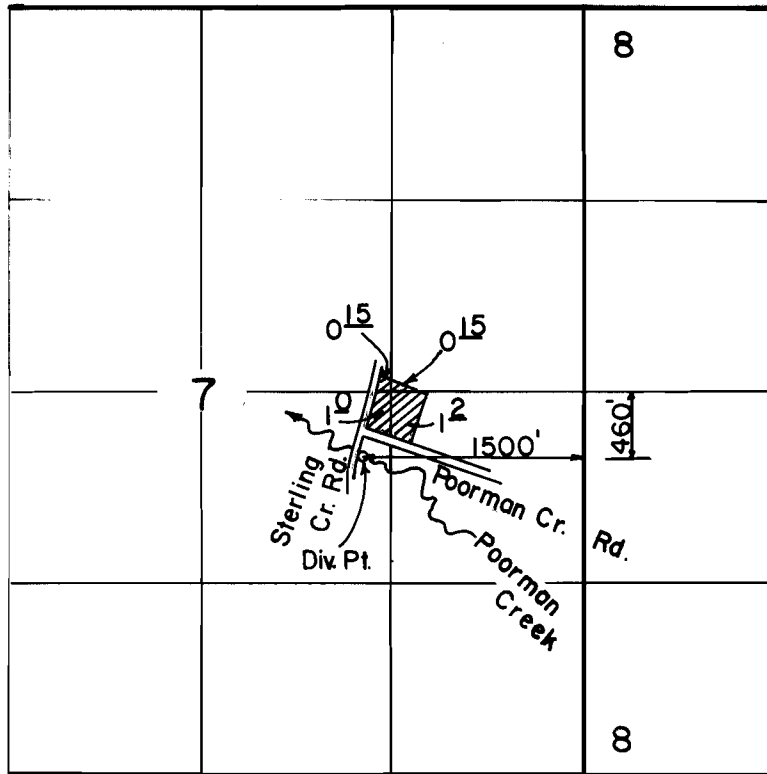

Scale: 1" = 1320'

FINAL PROOF SURVEY
UNDER

Application No. 61866 Permit No. 46507...
IN NAME OF

..... DANIEL R. MADDOX

Surveyed OCT. 7. 1991., by B. S. JAMES...