


T. 27 S., R. 7 W., W. M.

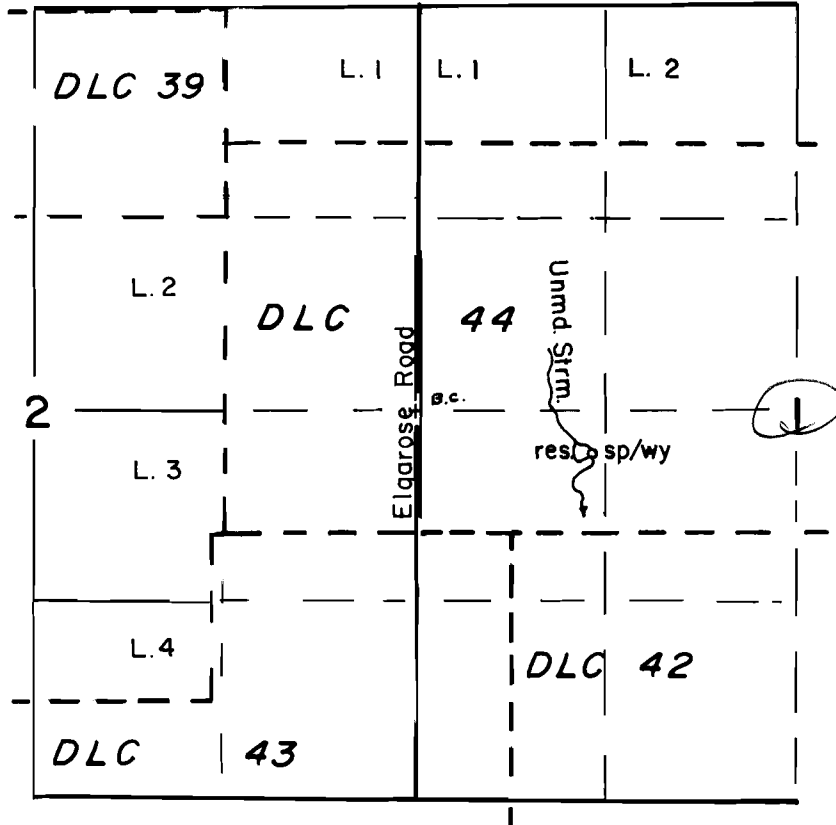

Scale: 1" = 1320'

**FINAL PROOF SURVEY
UNDER**

Application No. R-63104 Permit No. R-8408...
IN NAME OF

.....HELMY R. TEWFIK.....

Surveyed AUG. 28 1990, by B.S. JAMES....