


T.28S., R.6W., W.M.

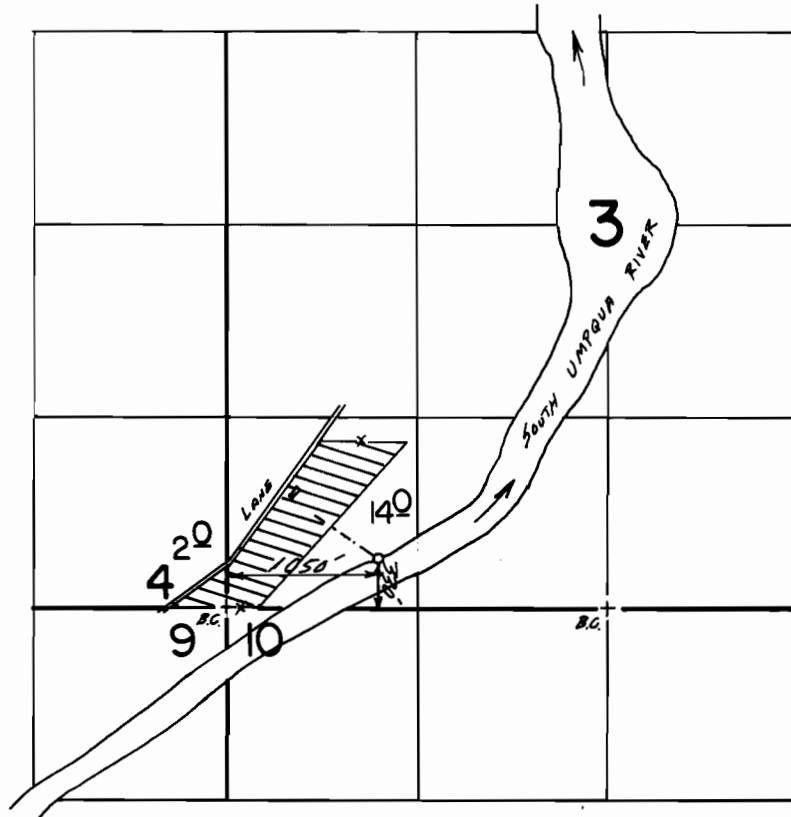

Scale 1" = 1320'

FINAL PROOF SURVEY UNDER

Application No. 63545. Permit No. 46833
IN NAME OF

BILL G. HENDERSON

Surveyed Aug. 2, 1990, by BS. JAMES
Dec. 6, 1983, by L. E. CASHION