


T. 32 S., R. 7 W., W.M.

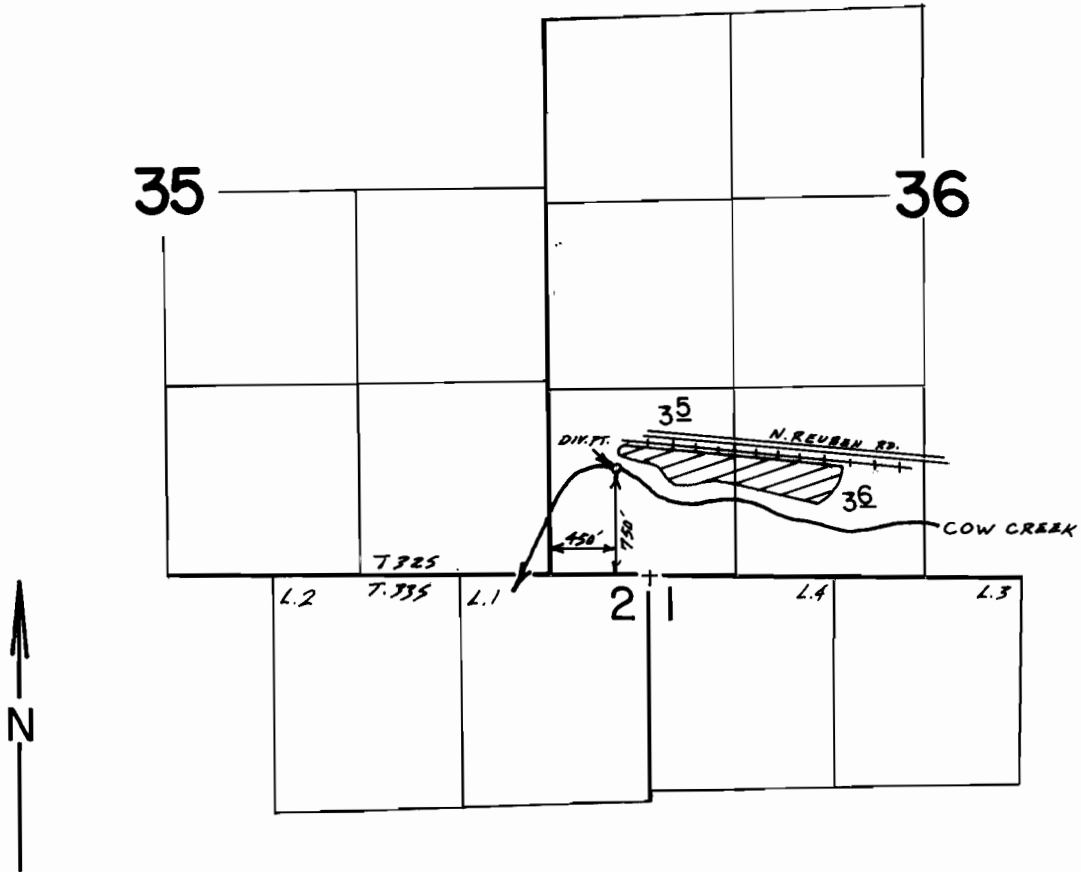

Scale 1"=1320'

**FINAL PROOF SURVEY  
UNDER**

Application No. 68355 Permit No. 49380...  
IN NAME OF

FRANK V. and or CHERI L. HURD

Surveyed July 11, 1990, by B.S. James.....