


# T. 24 S., R. 7 W. W.M.

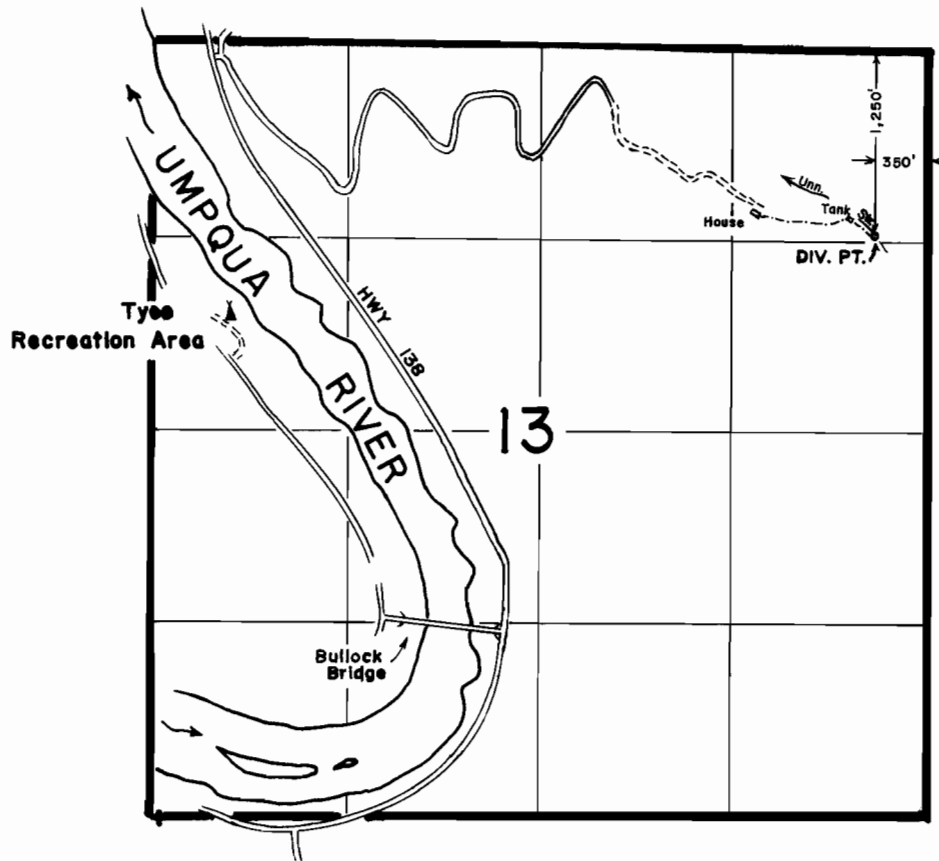

SCALE: 1" = 1,320'

## FINAL PROOF SURVEY UNDER

Application No. 69174. Permit No. 50113.....  
IN NAME OF

.....ELWIN H. PRICE.....

Surveyed Sept. 19 1920, by M. SCHMORDE.