


FINAL PROOF SURVEY
SEC. 31, T.37S., R.14W., W.M.
SEC. 6, T.38S., R.14W., W.M.

SCALE: 4" = 1 MILE

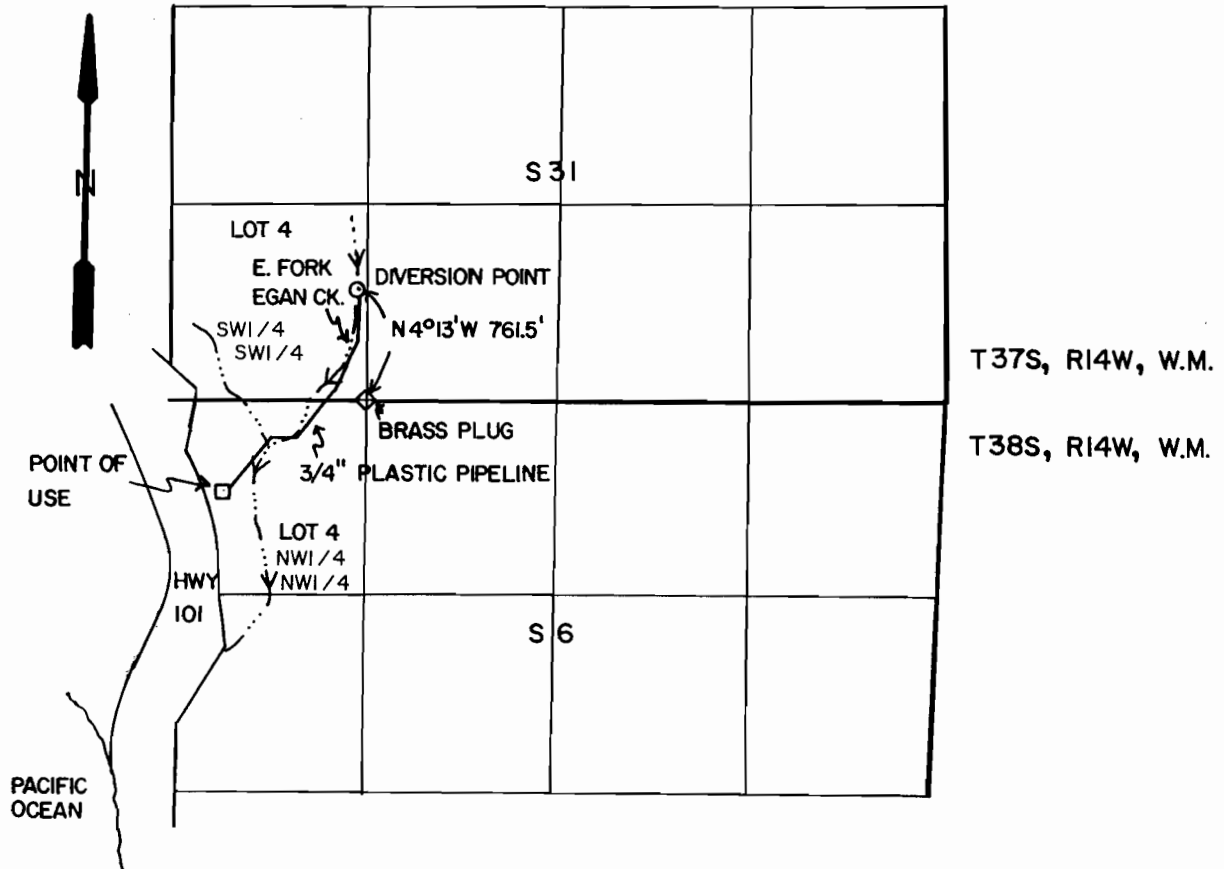

APPLICATION NO. 69648 PERMIT NO. 50454
IN THE NAME OF DAVID S. SCHREIBER

SURVEYED OCT. 10, 1988 BY THOMAS J. HOWIE, WRE 070
INSPECTED JULY, 4 1992.

THIS MAP SHOWS THE LOCATION OF A WATER RIGHT ONLY
AND HAS NO INTENT TO PROVIDE DIMENSIONS OR LOCATION
OF PROPERTY OWNERSHIP LINES.

