


THIS MAP WAS PREPARED FOR THE PURPOSE OF IDENTIFYING THE LOCATION OF A WATER RIGHT ONLY AND IS NOT INTENDED TO PROVIDE LEGAL DIMENSIONS OR LOCATION OF PROPERTY OWNERSHIP LINES.

RECEIVED


SEP 16 1991

WATER RESOURCES DEP
SALEM, OREGON

T.3S., R.4W., W.M.

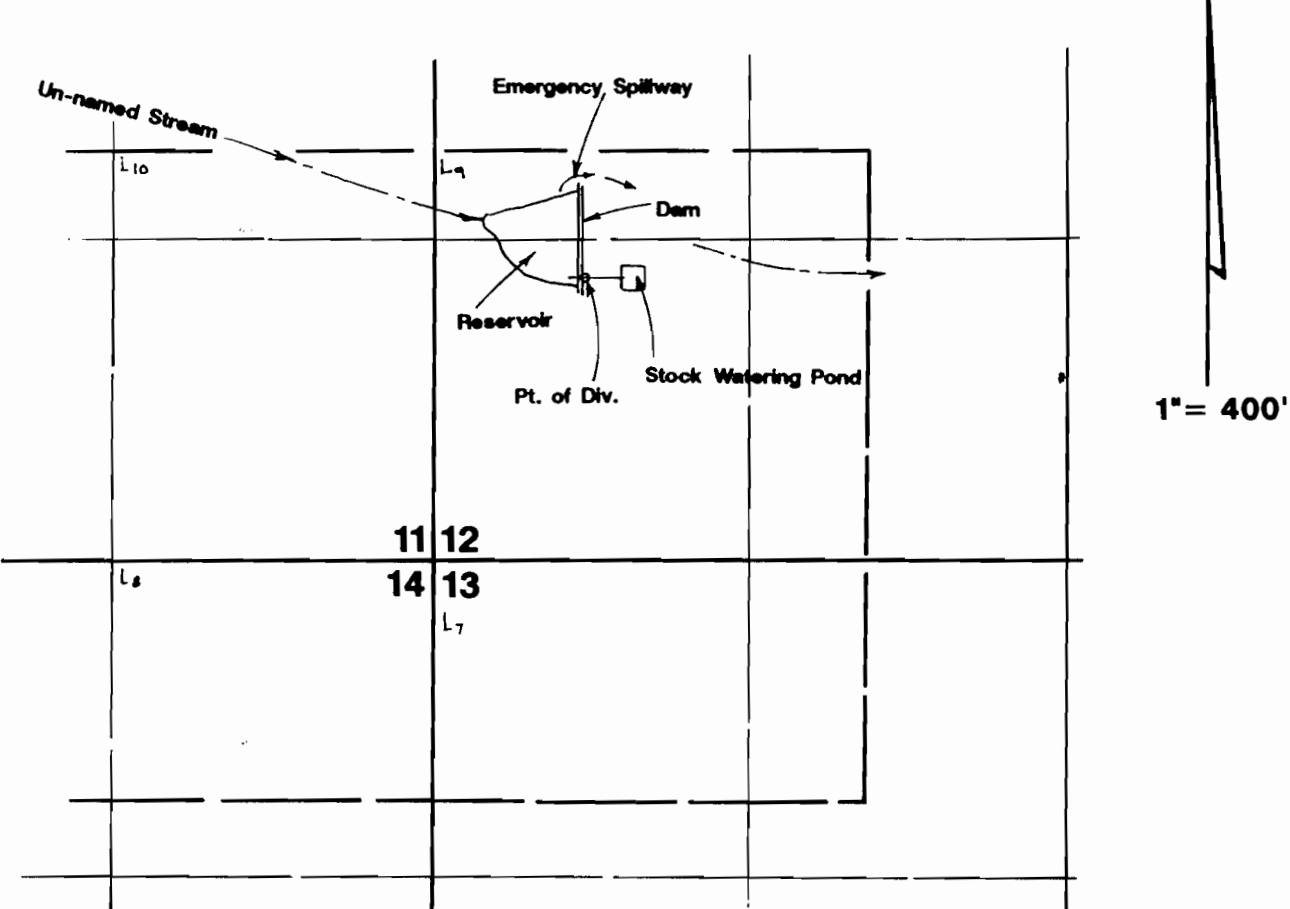

Point of diversion located 268'S & 580'W from the NE corner of Lot 9, NE¼ SW¼ Section 12.

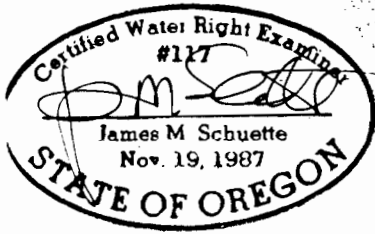

Final Proof Survey

Application #: R-69803 Permit #: R-11064

In Name Of

Ervin E. Briscoe

Surveyed on September 4, 1991 by JM Schuette