

51255
68163

4" DIAMETER
GALVANIZED IRON SPRING
BOX 1225 FEET NORTH &
590 FEET WEST OF SOUTHEAST
CORNER OF SECTION 29

SE 1/4
SECTION 29

SW 1/4
SECTION 28

3" PLASTIC WATER PIPE
(BURIED)

29 28


SECTION CORNER 32
FOUND 2 1/2" GALVANIZED IRON
PIPE WITH 3" BRASS CAP
SET IN 1969 BY ORE. L.S. 744

CABIN, COOK SHACK
BARN, WATER TROUGH

RIVER

NORTH FORK OF SPARGUE

NW 1/4
SECTION 33

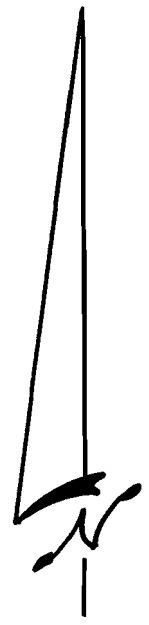

SCALE 1" = 400'

M. S. K. Morgan

RECEIVED

FINAL PROOF SURVEY MAP


IN

SECTIONS 28, 29 & 33 T34S R16E, W.M.

LAKE COUNTY, OREGON

APPLICATION NO. 70254

PERMIT NO. 51255

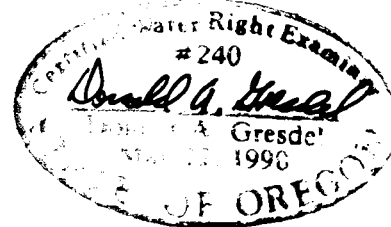

FOR: J-SPEAR RANCH COMPANY
P.O. BOX 257
KLAMATH FALLS, OR. 97601
TELE: 503-884-3177

JUNE 12, 1992

THE PURPOSE OF THIS MAP IS TO IDENTIFY THE LOCATION OF THE WATER RIGHT. IT IS NOT INTENDED TO PROVIDE INFORMATION RELATIVE TO THE LOCATION OF PROPERTY OWNERSHIP BOUNDARY LINES.