


FINAL PROOF SURVEY

SEC. 36, T.36S., R.14W., W.M.

SCALE 4" = 1 MILE

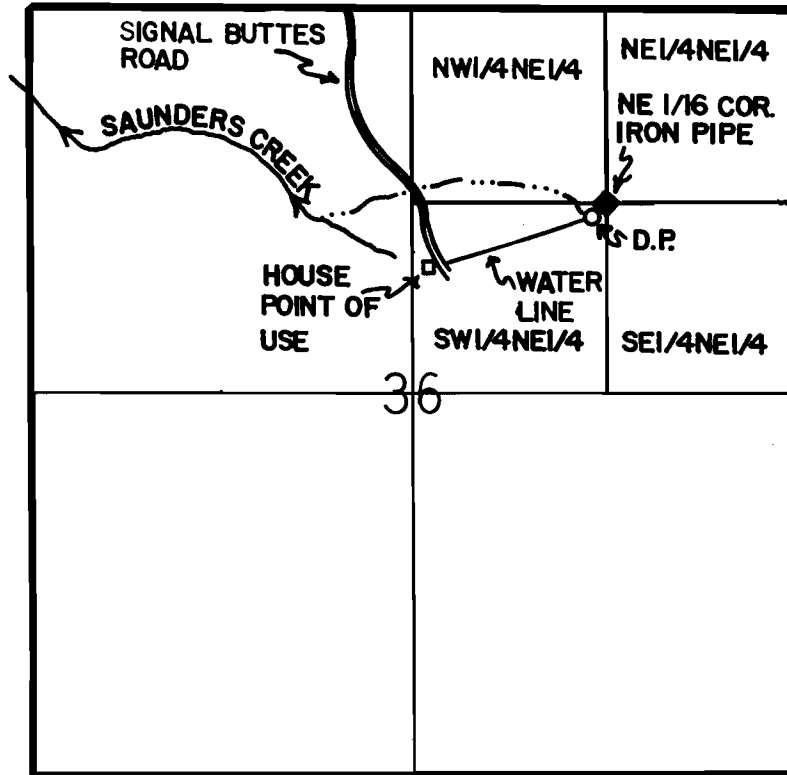

DIVERSION POINT (D.P.) LIES 114' S. & 27' W. OF THE N.E. 1/16 COR.

APPLICATION NO. 71039 PERMIT NO. 51173

IN THE NAME OF

CYNTHIA RICKS & JOHN SCHARFF

NOVEMBER 15, 1990

THOMAS J. HOWIE, W.R.E. 070

THE PREPARATION OF THIS MAP IS FOR THE PURPOSE OF IDENTIFYING THE LOCATION OF A WATER RIGHT ONLY AND HAS NO INTENT TO PROVIDE DIMENSIONS OR LOCATION OF PROPERTY OWNERSHIP LINES.

