

15  
22

**RECEIVED**

AUG 31 1992

WATER RESOURCES DEPT.  
SALEM, OREGON

MC

NW 1/4 NE 1/4

NE 1/4 NE 1/4

SW 1/4 NE 1/4

SE 1/4 NE 1/4

US HIGHWAY 101

1 1/4" PIPE  
POINT OF DIVERSION

WOAHINK LAKE



SCALE  
1" = 400'

22

22

# FINAL PROOF WATER RIGHTS MAP


SW 1/4, NE 1/4, SEC. 22, T 19 S, R 12 W, W.M.  
LANE COUNTY, OREGON

FOR: HENRY McKENNEY  
P.O. BOX 2416  
FLORENCE, OREGON 97439

PREPARED BY: WOBBE & ASSOCIATES, INC.  
510 KINGWOOD ST.  
P.O. BOX 1136  
FLORENCE, OREGON 97439

N 23° 28' E

3,820'

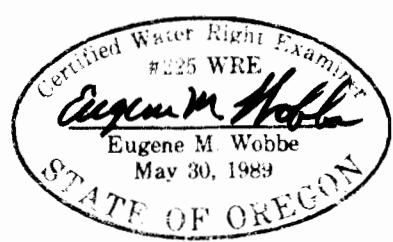

THIS MAP IS FOR THE PURPOSE  
OF IDENTIFYING THE LOCATION  
OF THE WATER RIGHT ONLY.  
THERE IS NO INTENT TO PROVIDE  
DIMENSIONS OR LOCATION OF  
PROPERTY OWNERSHIP LINES.