



T.33S.,R.1E., W.M.

FINAL PROOF MAP


APPLICATION NO. T-6367

IN THE NAME OF

ALBERTINA P. SOUZA

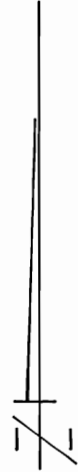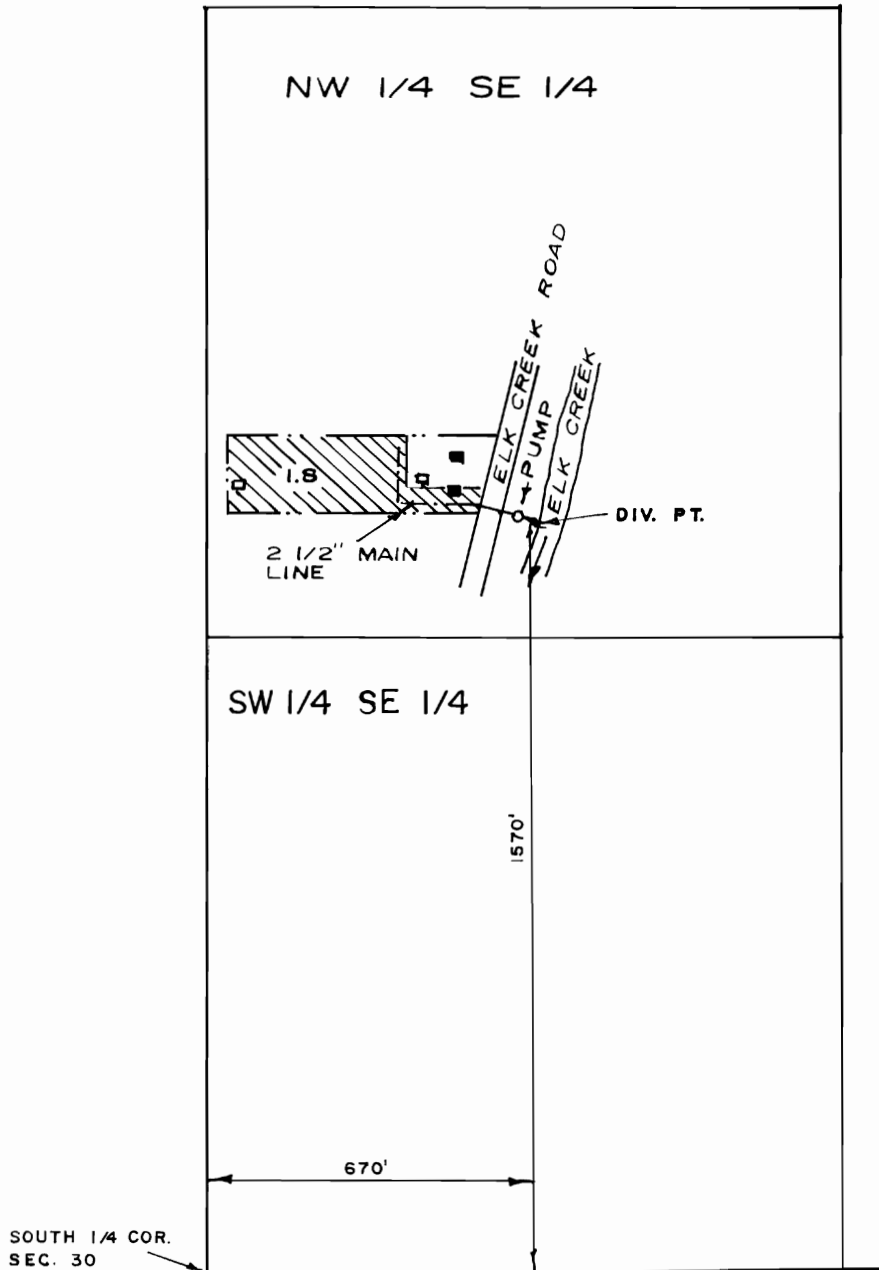

SCALE: 1" = 400'

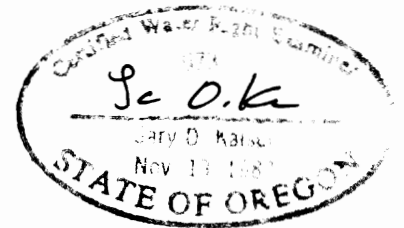

NOTE: THIS MAP HAS BEEN PREPARED FOR WATER RIGHT PURPOSES ONLY, NOT FOR PROPERTY BOUNDARY LOCATIONS

MAP PREPARED SEPTEMBER 25, 1991 BY GARY D. KAISER
ADDITIONS DECEMBER 22, 1992 GDK