

UNITED STATES
DEPARTMENT OF THE INTERIOR
BUREAU OF LAND MANAGEMENT

SECTION


SW¹NE¹ 32

Oregon State Water Filings

TOWNSHIP 38-S, RANGE 26-E, W. M.

*No corner found - tied in with Aerial
Photo and OSHD quad-sheet*

North

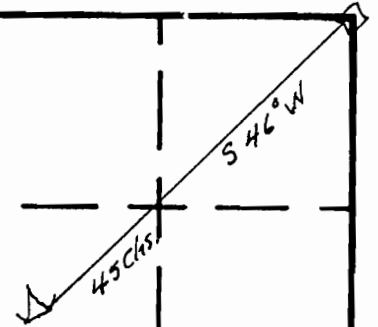

East

South

APPLICATION No. R-34699

PERMIT No. R-681