

Form, A1-187
March 1961

UNITED STATES
DEPARTMENT OF THE INTERIOR
BUREAU OF LAND MANAGEMENT

R-4202
68177

SECTION


10

SE $\frac{1}{4}$ SW $\frac{1}{4}$

Oregon State Water Filings

TOWNSHIP 39S, RANGE 26E, W. M.

North

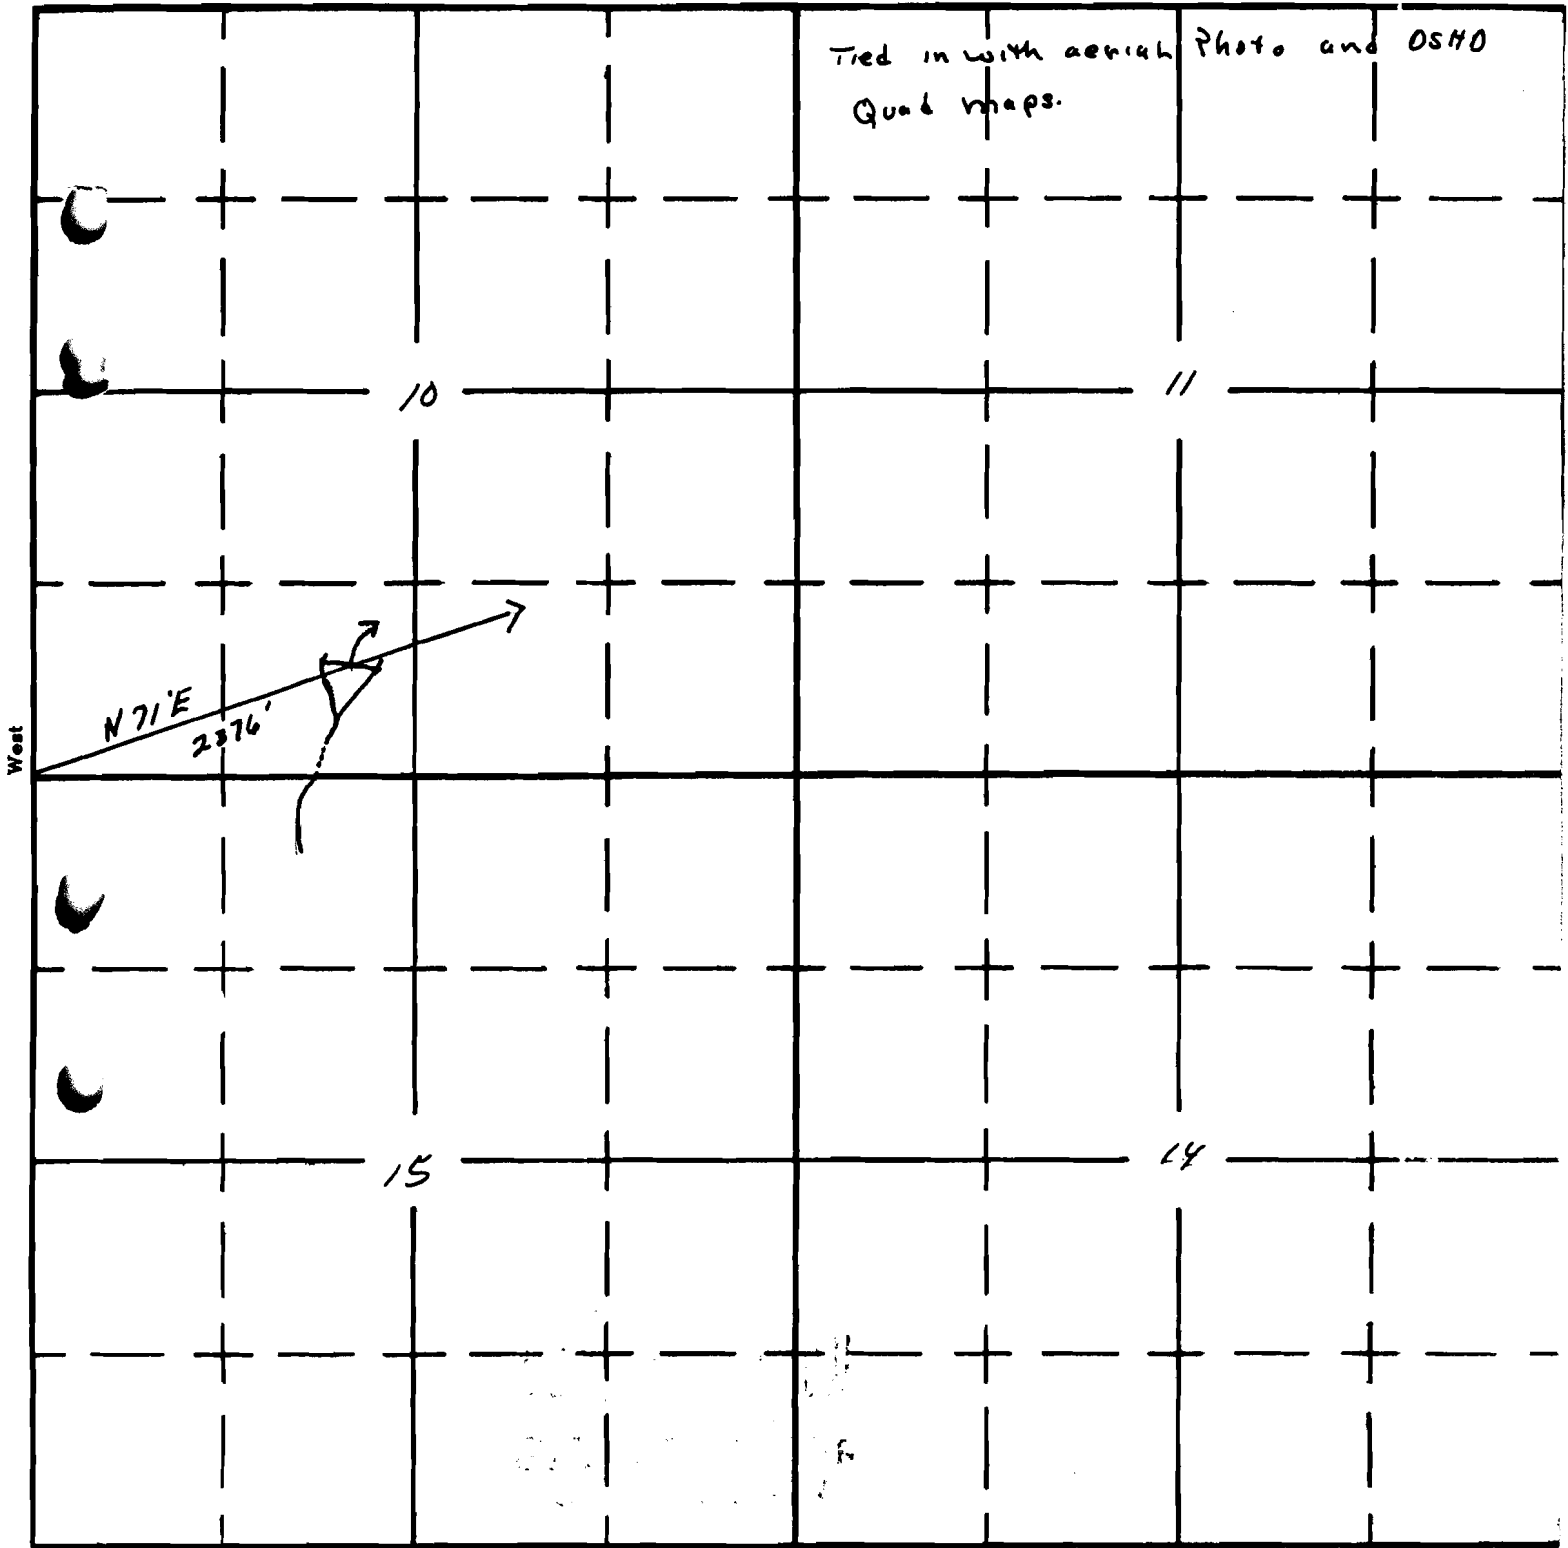

South

APPLICATION No. R-3581
PERMIT No. R-4202