


T.13 S. R.36 E., W.M.

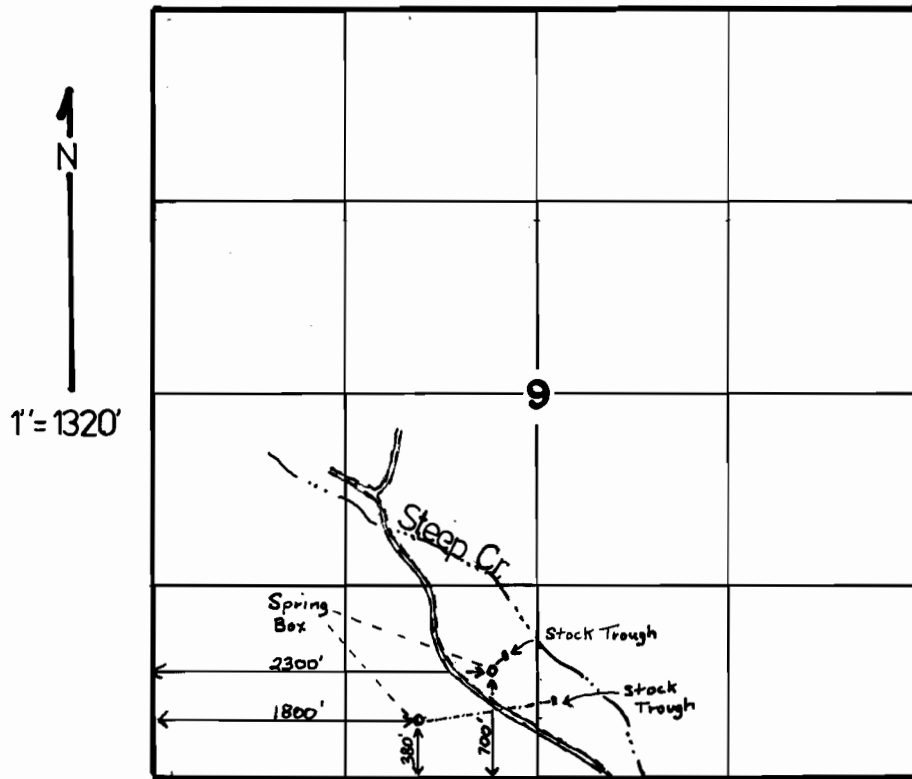

FINAL PROOF SURVEY
UNDER

Application No. **61314** Permit No. **48806**
IN NAME OF

UNITED STATES, WALLOWA-WHITMAN NATIONAL FOREST

Surveyed 9-24... 1991, by J. Miller.....

Drafted
2-3-92
J. Miller