

P-48837

scale 5.28 inches = 1 mile


T 17 S R 26 E Sec 5 NW 1/4 of NE 1/4

SUPLEE SPRING

RECEIVED

JUL 28 1981

WATER RESOURCES DEPT
SALEM, OREGON

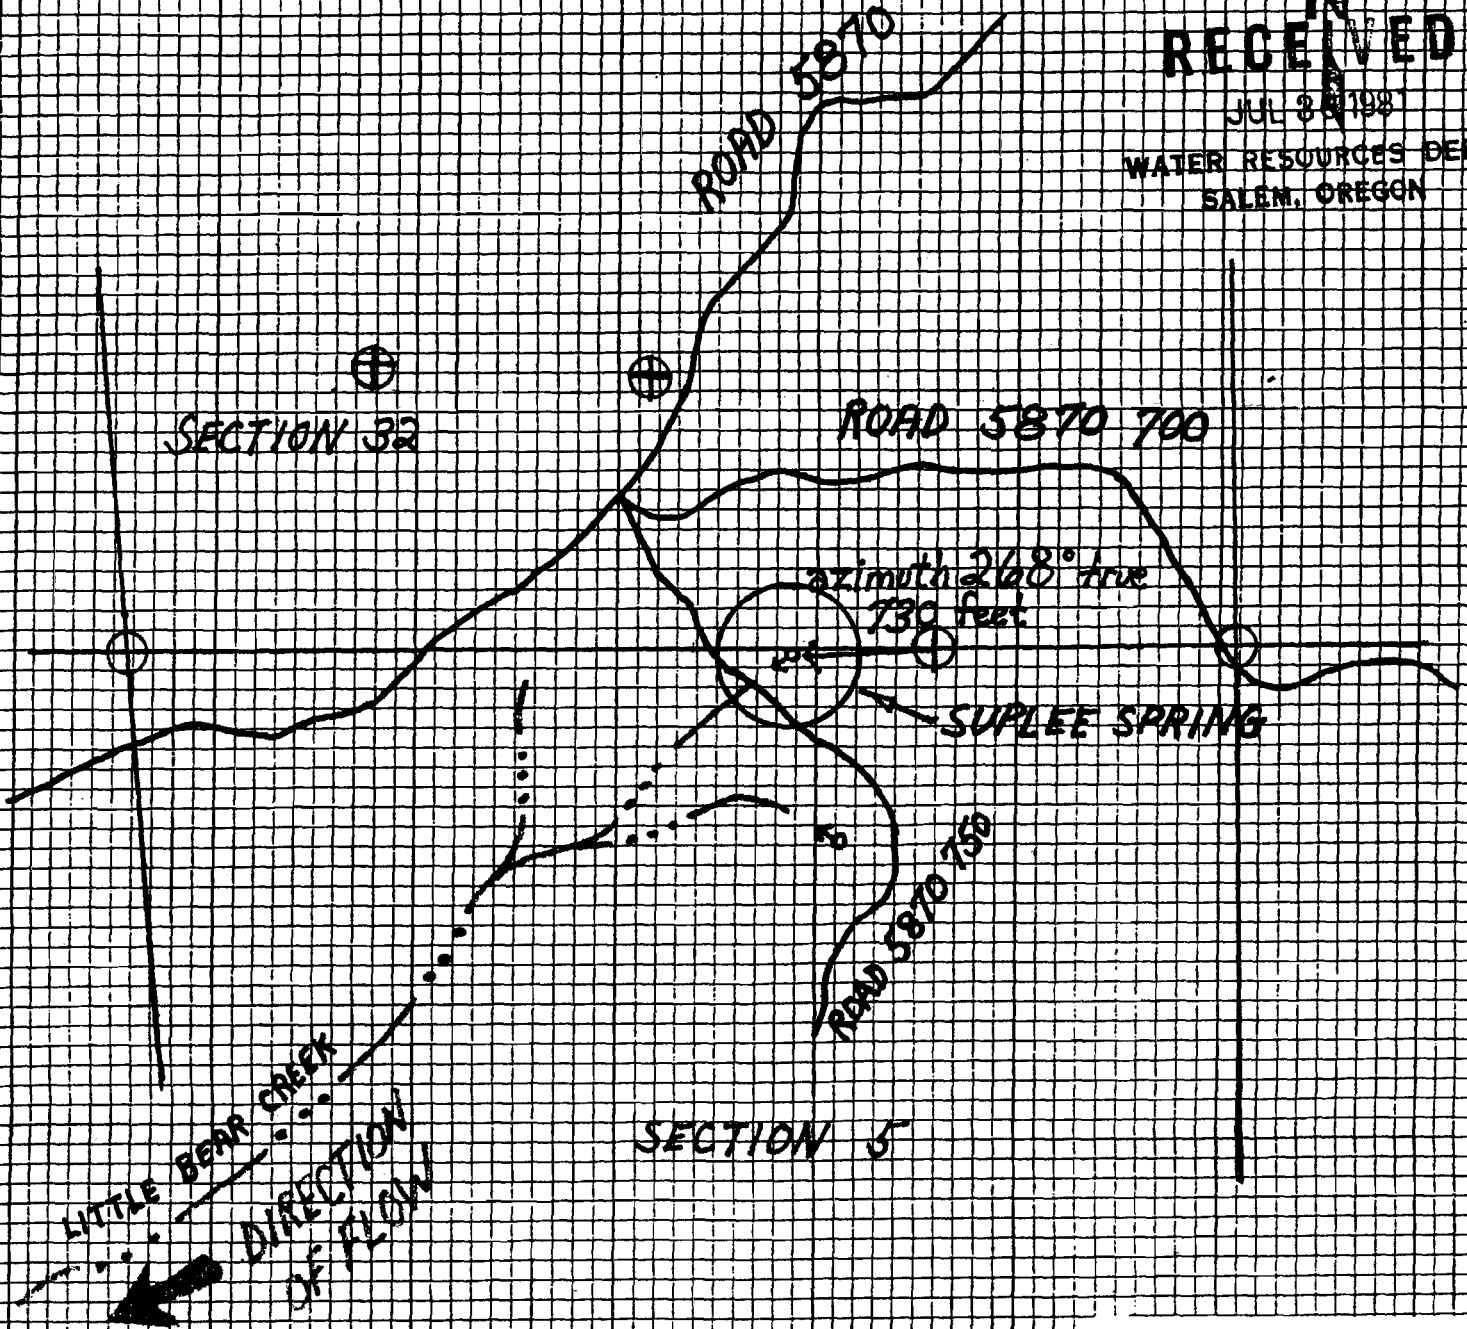

Application No. 61981
Permit No. 48837

key

- - spring
- - forest service road
- - - - - intermittent stream
- ⊕ - monumented land line

field work by
plotted by

J. Fitzpatrick & J. Kuhn
J. Fitzpatrick

date 4/13/81

Cert. # 68179
48837

RECEIVED MAR 18 1983