

scale 5.28 inches = 1 mile

T 17 S R 26 E Sec 4 NE 1/4 of SE 1/4

BEGG SPRING TROUGH

SECTION 33

SECTION 34

SECTION 4

SECTION 3

RECEIVED

SEP 11 1981

WATER RESOURCES DEPT  
SALEM, OREGON

Azimuth  
194° true  
4200 feet

BEGG SPRING

BEGG CREEK


DIRECTION  
OF FLOW

ROAD  
5870 700

Application No. 62697

Permit No. 48862

KEY

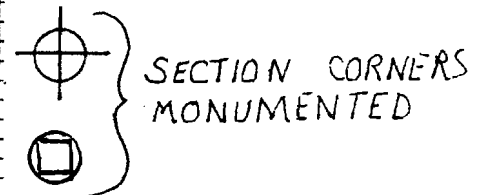

INTERMITTENT STREAM  
CHANNEL

ROAD cert. # 68180

SPRING (not to scale)  
48862

field work by Fitzpatrick & Kuhn date 7-9-80

platted by Fitzpatrick

RECEIVED MAR 18 1983