
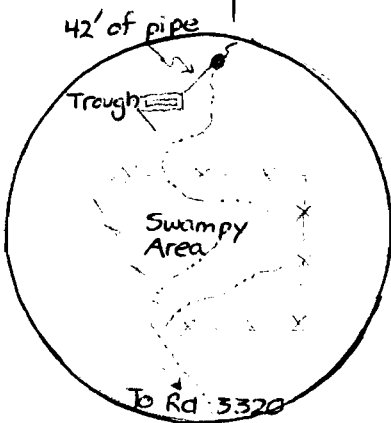


RECEIVED

SEP 11 1981

WATER RESOURCES DEPT
SALEM, OREGON

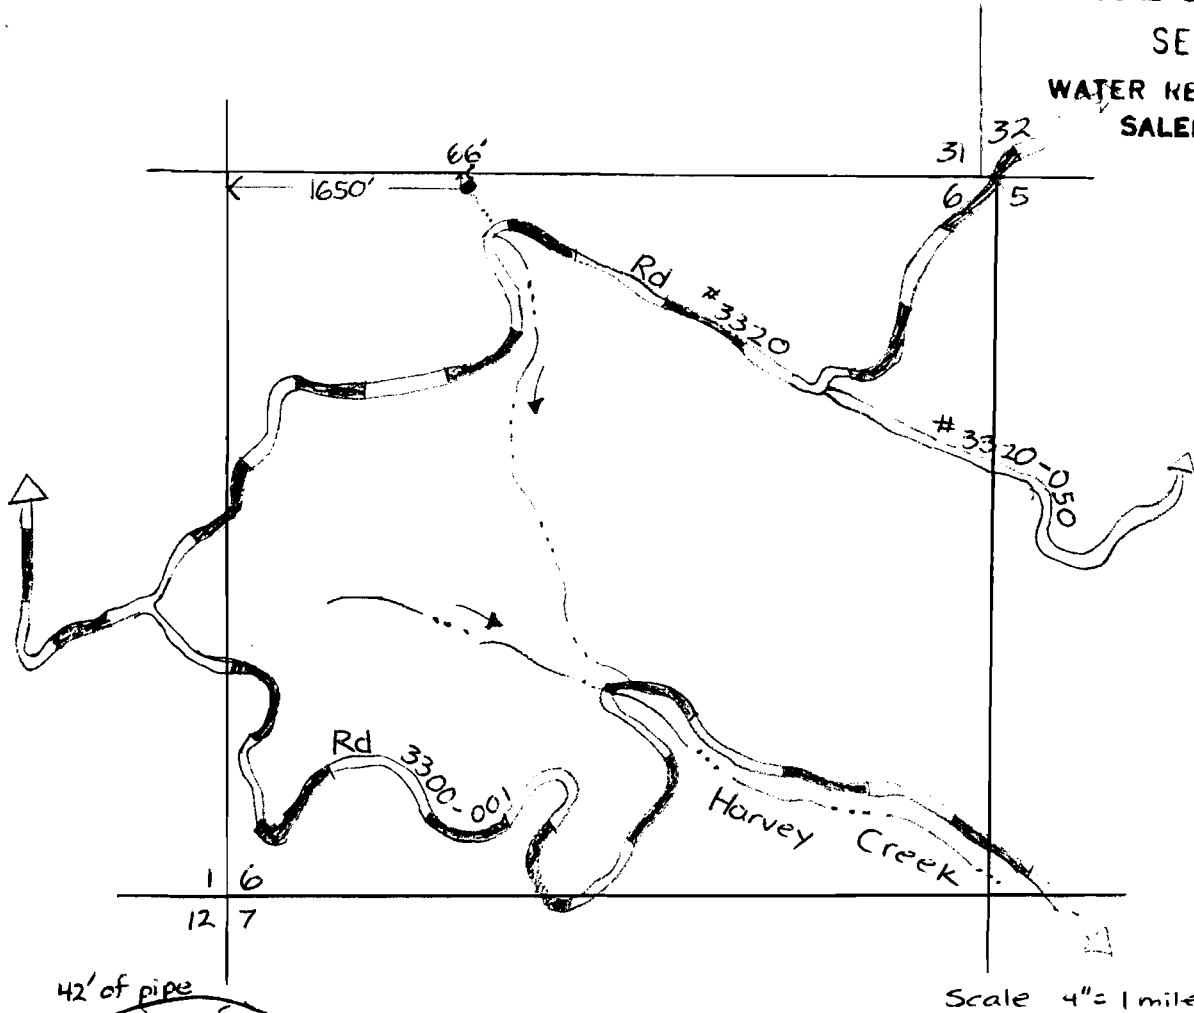

Hash Rock Spring
NE 1/4, NW 1/4, Sec. 6, T 13 S, R 18 E, W.M.

Application No. 62727
Permit No. 48660

Cert. #68181
48660

RECEIVED MAR 18 1993