


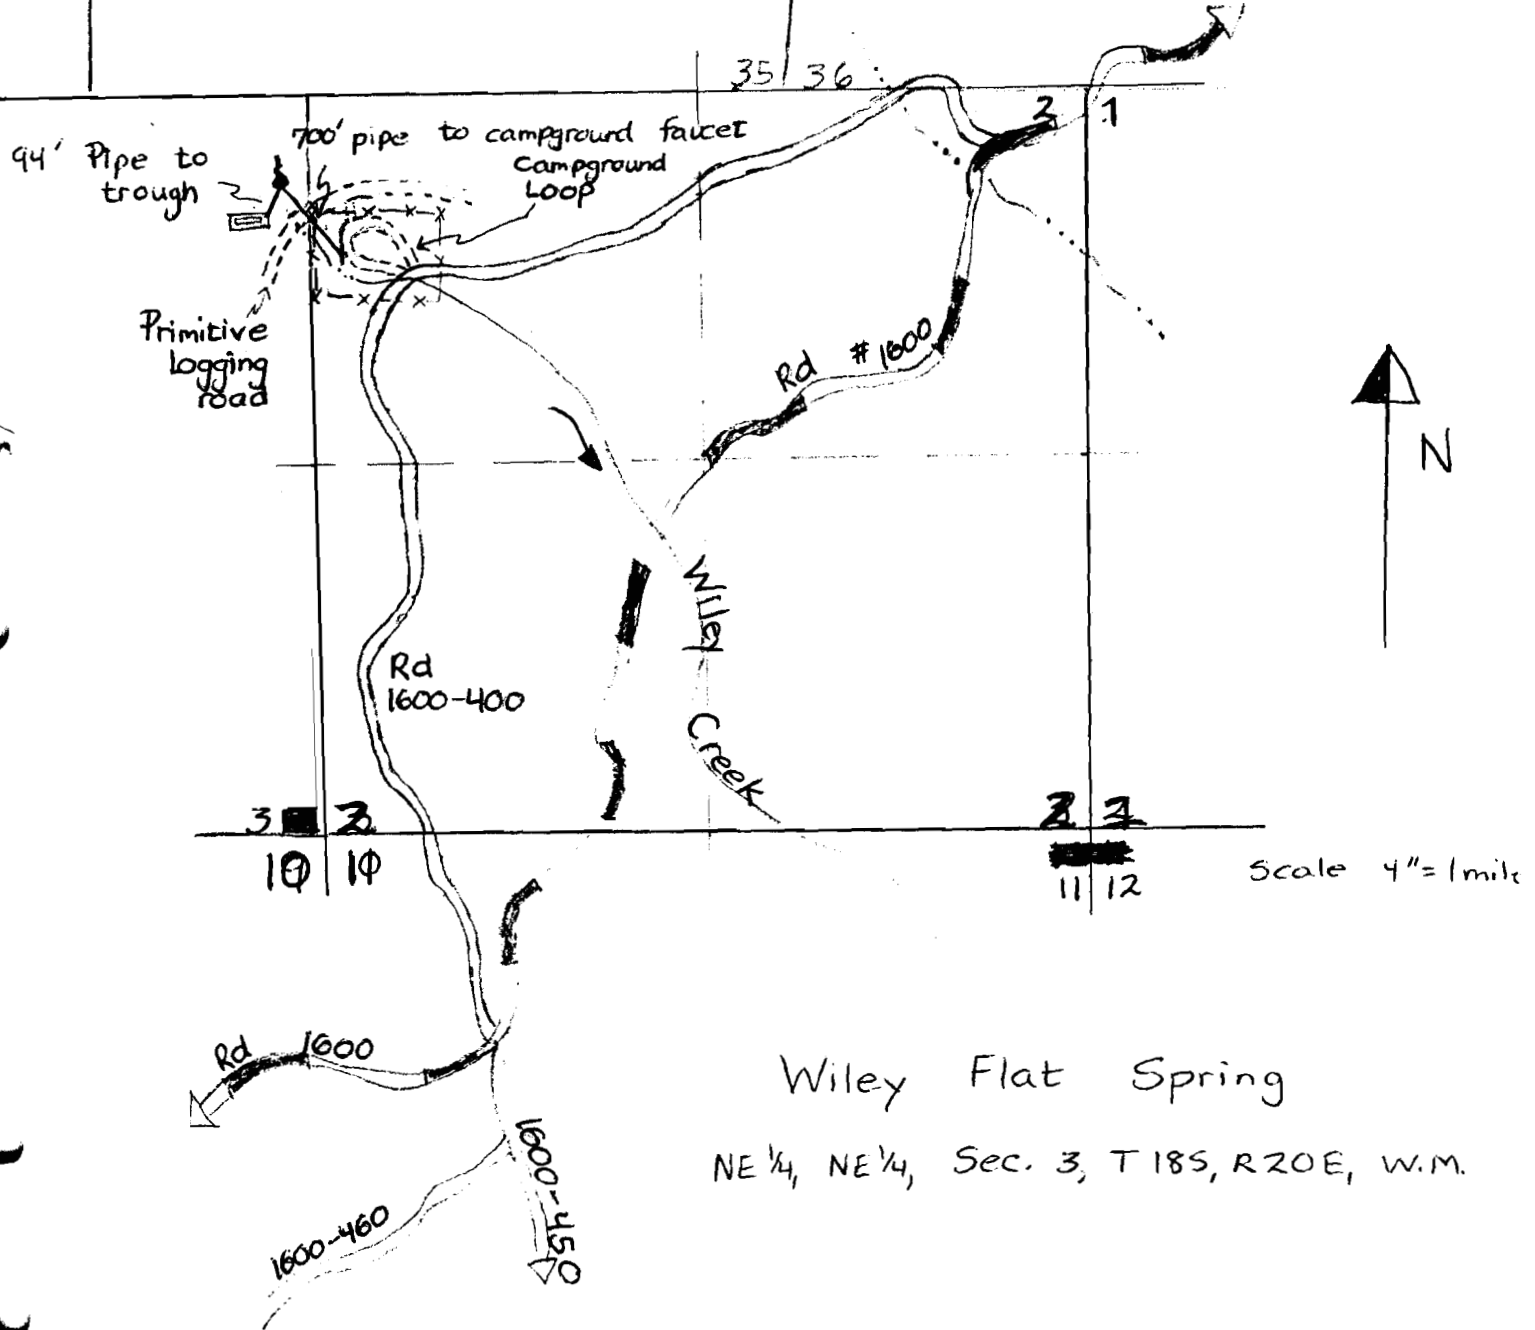

Wiley Flat Spring
NE 1/4, NE 1/4, Sec. 3, T18S, R20E, W.M.

Application No. 62716
Permit No. 48649

Cert. 68182
48649