



17 16  
20 21  
**RECEIVED**  
SEP 11 1981  
WATER RESOURCES DEPT  
SALEM, OREGON

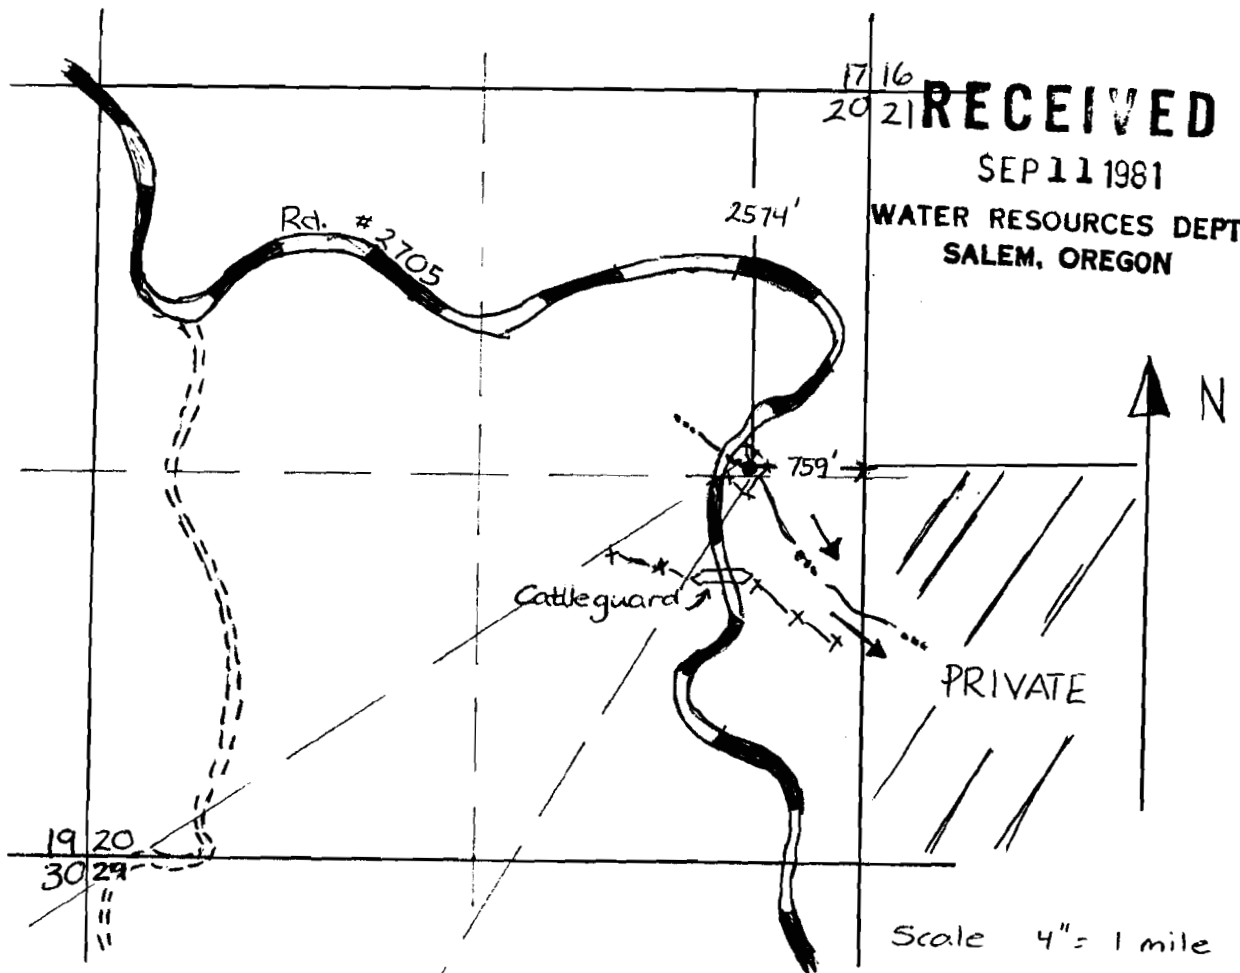

Cola Spring  
SE 1/4, NE 1/4, Sec 20, T12S, R17E, W.M

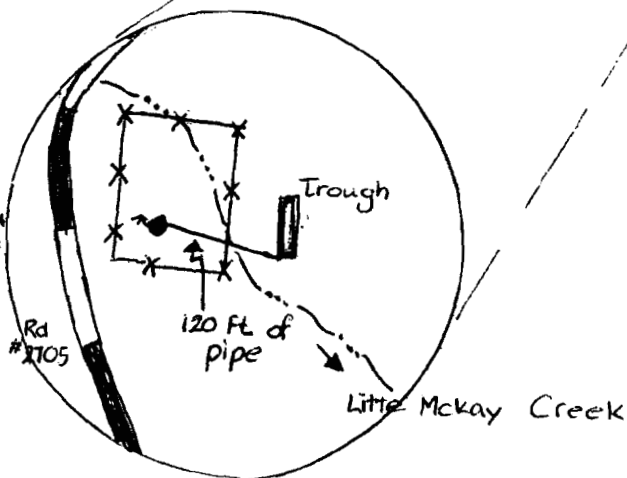

Application No. 62734  
Permit No. 48667

Cert. #68183

48667

1003