


RECEIVED

SEP 11 1981

WATER RESOURCES DEPT
SALEM, OREGON

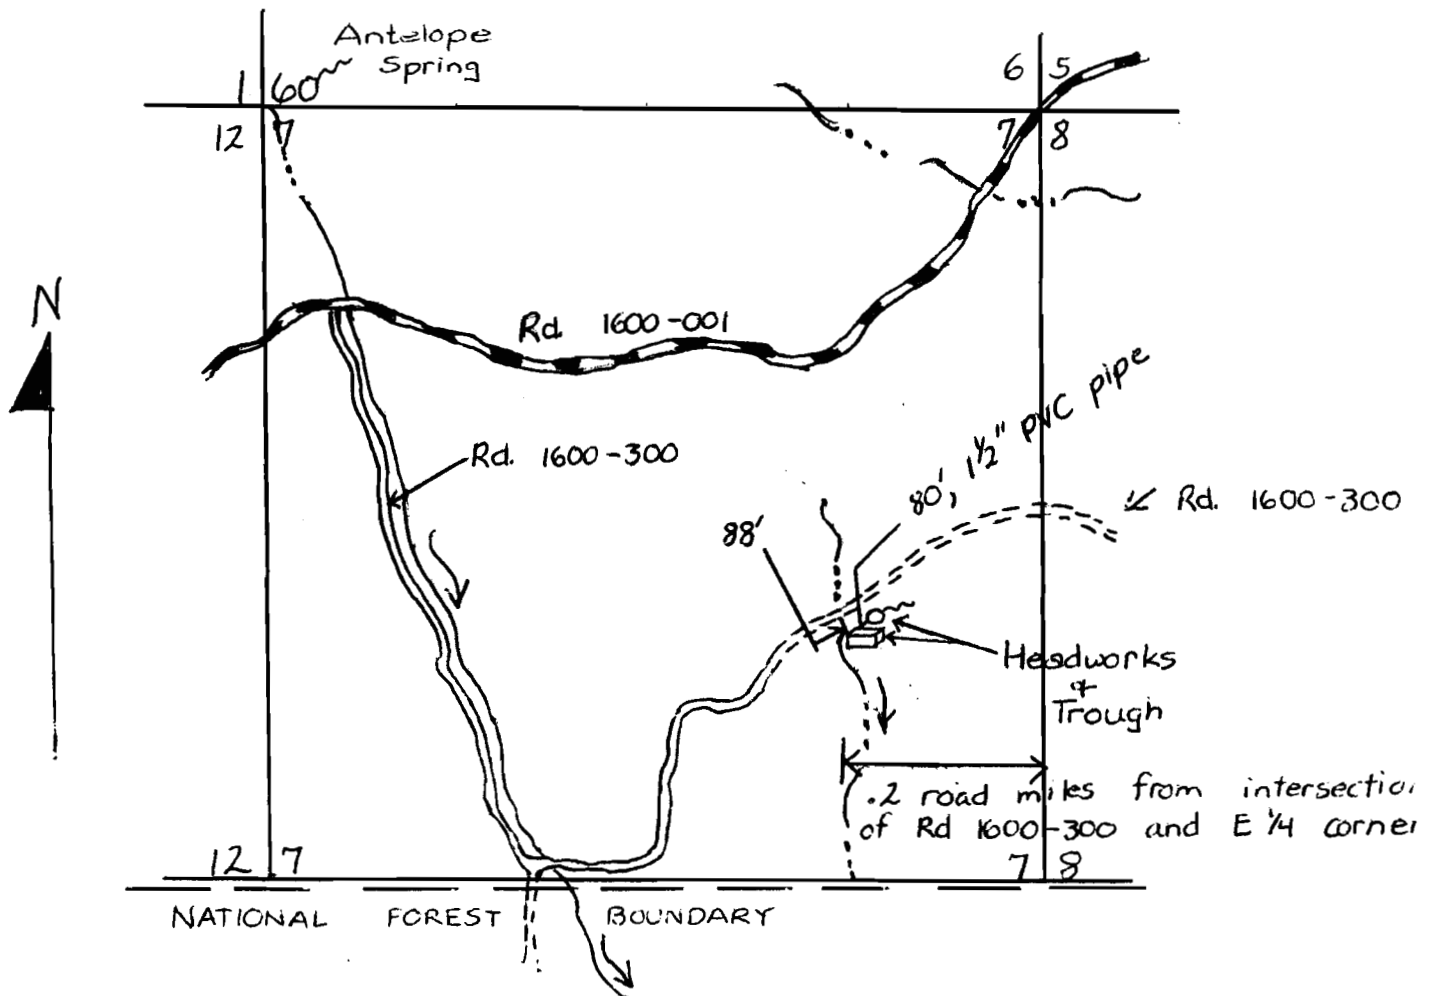

SPRING LOCATED: 1606 ft. N. and 1232 ft. W. from the SE corner
Section 7, T. 18 S., R. 20 E., WM

TOM SPRING

NE $\frac{1}{4}$, SE $\frac{1}{4}$, Sec. 7, T18S, R20E, W.M.

Scale: 4" = 1 mile

Application No. 62737
Permit No. 48670

Cert. #68184

48670