

STATE OF OREGON WATER RESOURCES DEPARTMENT
APPLICATION FOR A PERMIT TO APPROPRIATE SURFACE WATER

Application No. 65715
Permit No. 48740

APPLICANT: USDA FOREST SERVICE, MT. HOOD NATIONAL FOREST
2955 N. W. DIVISION ST., GRESHAM, OR 97030

WATER DEVELOPMENT NAME McCLURE'S SPRING



LOCATION: Township 1 S Range 10 E Section 1

Ranger District HOOD RIVER

RECEIVED


AUG 26 1983

WATER RESOURCES DEPT.
SALEM, OREGON

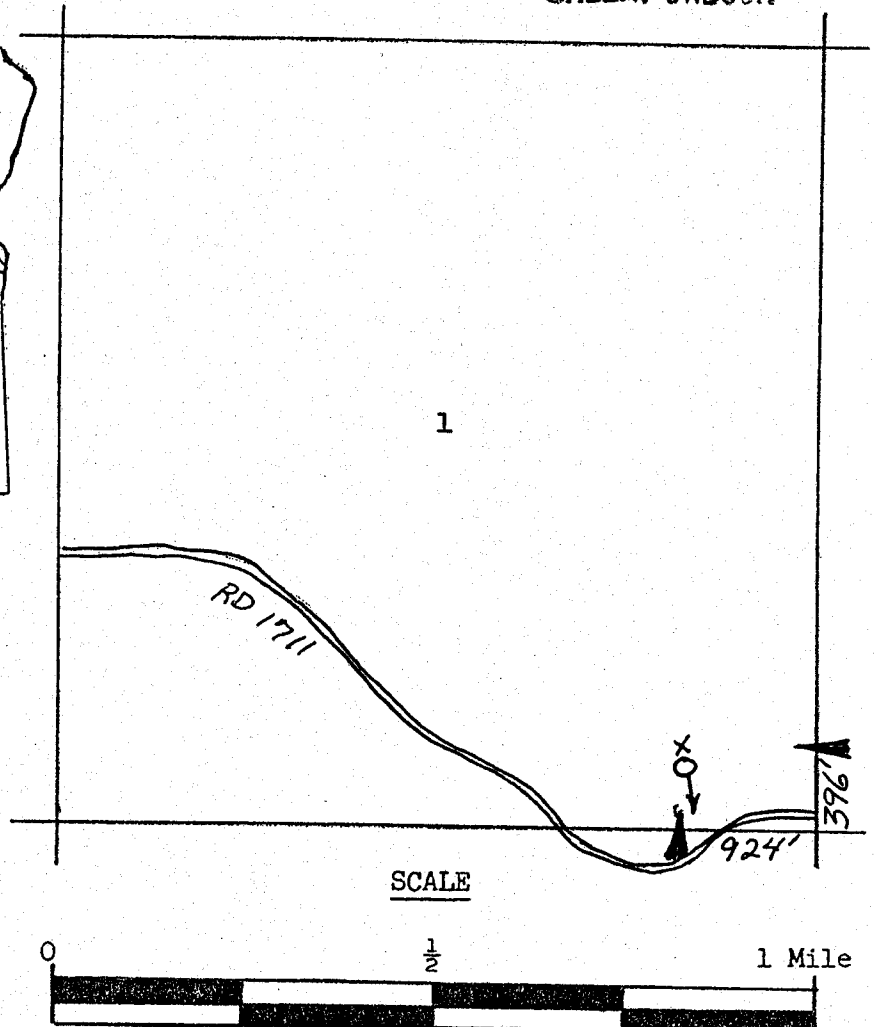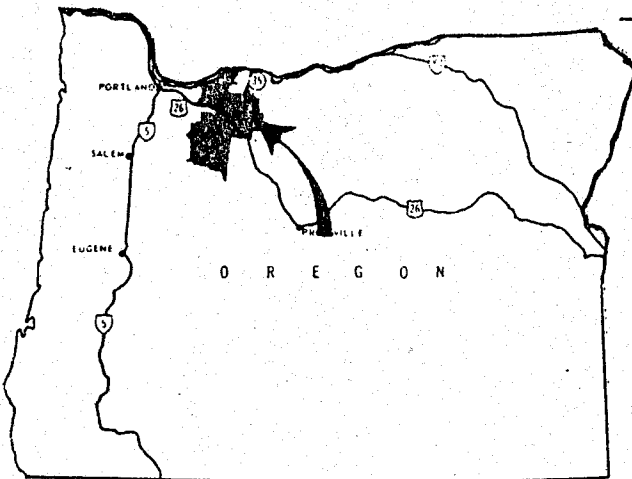


4" to 1 mile

TYPICAL POND DEVELOPMENT

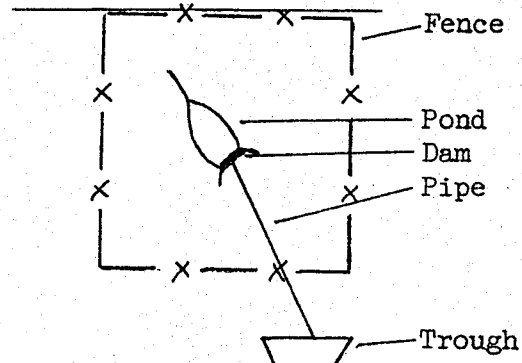

TYPICAL SPRING DEVELOPMENT

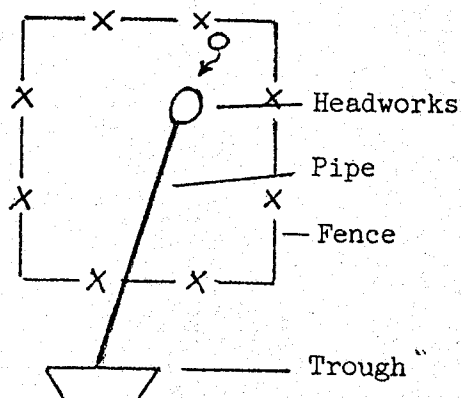

LEGEND

Intermittant Stream	→ →
Perennial Stream	→ ————— →
Flow Direction	→ ————— →
Road	=====
Exclosure Fence	— X — X —
Pond	∩
Spring	○