



SCALE  
4" = 1 mile  
NORTH

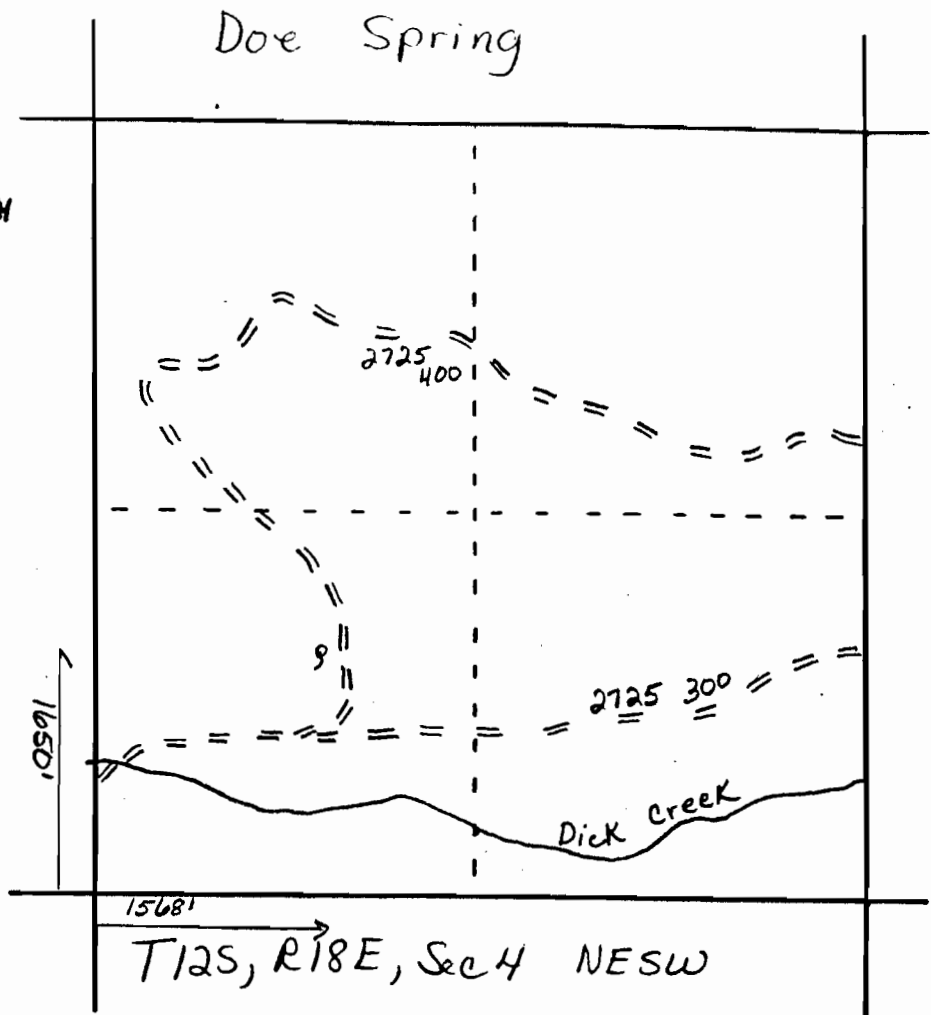

Application No. 66354  
Permit No. 49539

North  
scale: 1 inch = 40 feet

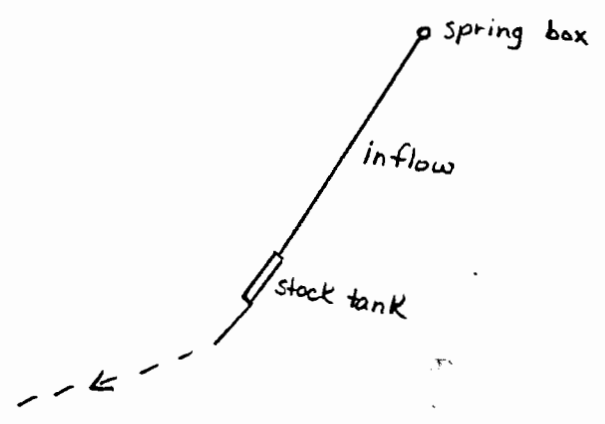

SEP 9 1983  
SALWATER DIVISION  
SALWATER DIVISION