


T12S, R18E, Sec 13, SE 1/4 NW 1/4

SCALE
4" = 1 mile

NORTH

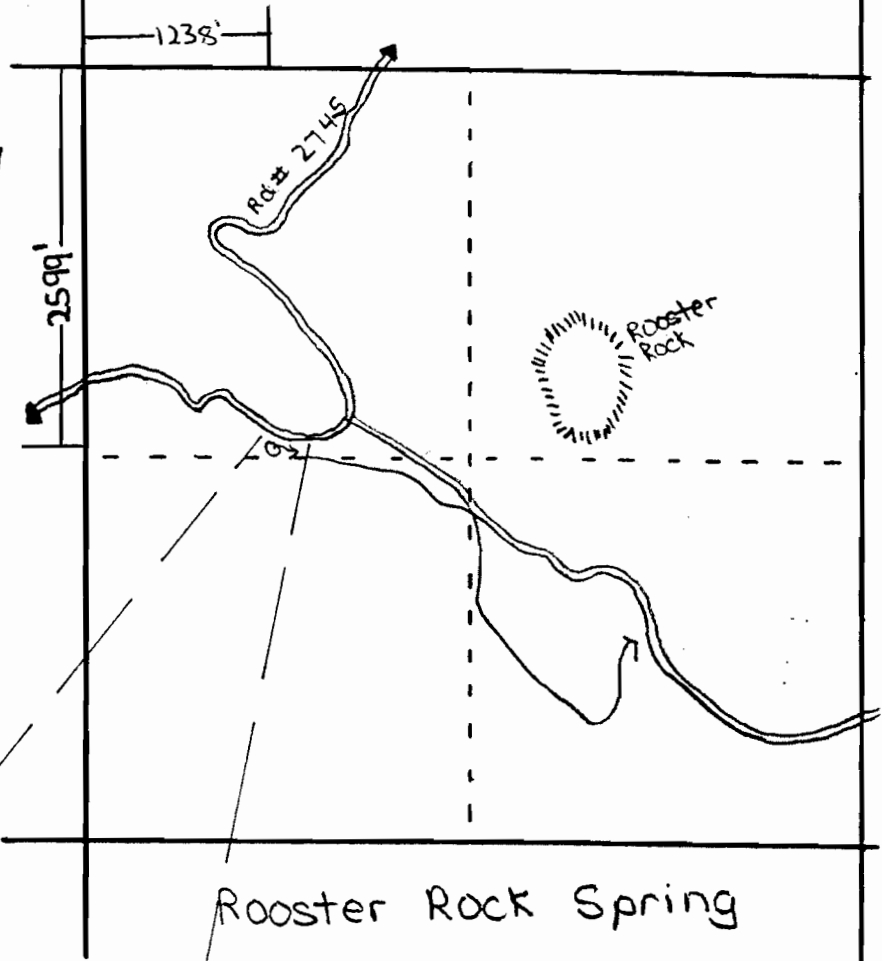

Application No. 66360
Permit No. 49545

trough

head works

Scale 1 inch = 40 Feet

SEP 9 1983

U.S. DEPT.
SALINITY DIVISION